


1 LOCATION OF WATER WELL:		Fraction	Section Number	Township Number	Range Number
County:	<i>Sedburgh</i>	<i>SW 1/4 SW 1/4 NW 1/4</i>	<i>25</i>	T <i>28</i> S	R <i>2</i> E <i>1</i>

Distance and direction from nearest town or city street address of well if located within city? 2 W 1/2 N 0763rd & N.Hill Rd EAST

2 WATER WELL OWNER: LEVI EAREHART AREHART
 RR#, St. Address, Box # :
 City, State, ZIP Code : AUGUSTA KS 67010

Board of Agriculture, Division of Water Resources
 Application Number:

3 LOCATE WELL'S LOCATION WITH AN "X" IN SECTION BOX: 4 DEPTH OF COMPLETED WELL 85 ft. ELEVATION: 11

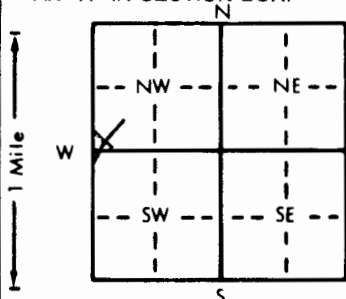

4 DEPTH OF COMPLETED WELL 85 ft. ELEVATION: _____
 Depth(s) Groundwater Encountered 1. 65 ft. 2. _____ ft. 3. _____ ft.
 WELL'S STATIC WATER LEVEL 30 ft. below land surface measured on mo/day/yr _____

Pump test data: Well water was _____ ft. after _____ hours pumping _____ gpm

Est. Yield 25 gpm: Well water was _____ ft. after _____ hours pumping _____ gpm

Bore Hole Diameter 10 in. to ft., and in. to ft.

WELL WATER TO BE USED AS:

1 Domestic	3 Feedlot	5 Public water supply	8 Air conditioning	11 Injection well
2 Irrigation	4 Industrial	6 Oil field water supply	9 Dewatering	12 Other (Specify below)
		7 Lawn and garden only	10 Observation well	

Was a chemical/bacteriological sample submitted to Department? Yes.....No ☒.....; If yes, mo/day/yr sample was submitted

5	TYPE OF BLANK CASING USED:	5 Wrought iron	8 Concrete tile	CASING JOINTS: <u>Glued</u> Clamped
	1 Steel	6 Asbestos-Cement	9 Other (specify below)	Welded
	<u>2 PVC</u>	7 Fiberglass		Threaded
	3 RMP (SR)			
	4 ABS			

Blank casing diameter 5 in. to _____ ft., Dia _____ in. to _____ ft., Dia _____ in. to _____ ft.
Casing height above land surface + 12 in., weight 160 lbs./ft. Wall thickness or gauge No. _____

TYPE OF SCREEN OR PERFORATION MATERIAL:

1 Steel	3 Stainless steel	5 Fiberglass	7 PVC	10 Asbestos-cement
2 Brass	4 Galvanized steel	6 Concrete tile	8 RMP (SR)	11 Other (specify)
			9 ABS	12 None used (open hole)

SCREEN OR PERFORATION OPENINGS ARE:

1 Continuous slot	3 <u>Mill slot</u>	5 Gauzed wrapped	8 Saw cut	11 None (open hole)
2 Louvered shutter	4 Key punched	6 Wire wrapped	9 Drilled holes	
		7 Torch cut	10 Other (specify)	

SCREEN-PERFORATED INTERVALS: From 65 ft. to 85 ft., From _____ ft. to _____ ft.
From _____ ft. to _____ ft., From _____ ft. to _____ ft.

GRAVEL PACK INTERVALS: From 20 ft. to 85 ft., From _____ ft. to _____ ft.
From _____ ft. to _____ ft., From _____ ft. to _____ ft.

6 GROUT MATERIAL: 1 Neat cement 2 Cement grout 3 Bentonite 4 Other

Grout intervals: From 3 ft to 30 ft From ft to ft

What is the nearest source of possible contamination:

1 <u>Septic tank</u>	4 Lateral lines	7 Pit privy	10 Livestock pens	14 Abandoned water well
2 Sewer lines	5 Cess pool	8 Sewage lagoon	11 Fuel storage	15 Oil well/Gas well
3 Watertight sewer lines	6 Seepage pit	9 Feedyard	12 Fertilizer storage	16 Other (specify below)
			13 Insecticide storage	

Direction from well? How many feet? ***50**

[illegible]

7 CONTRACTOR'S OR LANDOWNER'S CERTIFICATION: This water well was (1) constructed, (2) reconstructed, or (3) plugged under my jurisdiction and was completed on (mo/day/year) 7/19/85 and this record is true to the best of my knowledge and belief. Kansas

Water Well Contractor's License No. 424 This Water Well Record was completed on (mo./day/yr) 8/10/18
under the business name of REISERER WELL DRILLING by (signature) [Signature]

INSTRUCTIONS: Use typewriter or ball point pen, PLEASE PRESS FIRMLY and PRINT clearly. Please fill in blanks, underline or circle the correct answers. Send top three copies to Kansas Department of Health and Environment, Division of Environment, Environmental Geology Section, Topeka, KS 66620. Send one to WATER WELL OWNER and retain one for your records.