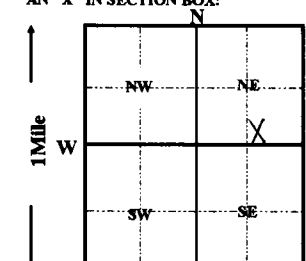


1 LOCATION OF WATER WELL: Sedgwick		FRACTION SW 1/4 SE 1/4 NE 1/4		Section Number 21		Township Number T 28 S		Range Number R 2E E/W	
Distance and direction from nearest town or city street address of well if located within city? 1/2 S. of 47th S. and 1/4 West of Greenwich Rd. Wichita, Kansas									
2 WATER WELL OWNER: KREFT RR#, ST. ADDRESS, BOX #: 10700 Quail Circle CITY, STATE, ZIP CODE: Wichita, Kansas		Board of Agriculture, Division of Water Resource Application Number:							
3 LOCATE WELL'S LOCATION WITH AN "X" IN SECTION BOX: 		4 DEPTH OF COMPLETED WELL 65 ft. ELEVATION: Depth(s) groundwater Encountered 1 ft. 2 ft. 3 ft. WELL'S STATIC WATER LEVEL 20 FT. BELOW LAND SURFACE MEASURED ON 01/20/1995 Pump test data: Well water was ft. after hours pumping gpm Est. Yield gpm : Well water was ft. after hours pumping gpm Bore Hole Diameter 12 in. to 65 ft. and in. to ft. WELL WATER TO BE USED AS: 5 Public water supply 8 Air conditioning 11 Injection well 1 Domestic 3 Feedlot 6 Oil field water supply 9 Dewatering 12 Other (Specify below) 2 Irrigation 4 Industrial 7 Lawn and garden only 10 Monitoring well Was a chemical/bacteriological sample submitted to Department? Yes No X ; If yes, mo/day/yr sample was submitted Water Well Disinfected? Yes X No							
5 TYPE OF CASING USED: 1 Steel 3 RMP (SR) 5 Wrought iron 8 Concrete tile CASING JOINTS: Glued X Clamped 2 <u>PVC</u> 4 ABS 6 Asbestos-Cement 9 Other (Specify below) Welded Blank casing Diameter 5 in. to 25 ft., Dia in. to ft., Dia in. to ft. Casing height above land surface 12 in., weight 2.35 lbs./ft. Wall thickness or gauge No. .214 TYPE OF SCREEN OR PERFORATION MATERIAL: 7 <u>PVC</u> 10 Asbestos-cement 1 Steel 3 Stainless Steel 5 Fiberglass 8 RMP (SR) 11 other (specify) 2 Brass 4 Galvanized steel 6 Concrete tile 9 ABS 12 None used (open hole) SCREEN OR PERFORATION OPENING ARE: 5 Gauzed wrapped 8 <u>Saw cut</u> 11 None (open hole) 1 Continuous slot 3 Mill slot 6 Wire wrapped 9 Drilled holes 2 Louvered shutter 4 Key punched 7 Torch cut 10 Other (specify) SCREEN-PERFORATION INTERVALS: from 25 ft. to 65 ft., From ft. to ft. GRAVEL PACK INTERVALS: from 24 ft. to 65 ft., From ft. to ft. GROUT MATERIAL: 1 Neat cement 2 <u>Cement grout</u> 3 Bentonite 4 Other Grout Intervals: From 4 ft. to 24 ft., From ft. to ft. What is the nearest source of possible contamination: 10 Livestock pens 14 Abandon water well 1 Septic tank 4 Lateral lines 7 <u>Pit privy</u> 11 Fuel storage 15 Oil well/Gas well 2 Sewer lines 5 Cess pool 8 <u>Sewage lagoon</u> 12 Fertilizer storage 16 Other (specify below) 3 Watertight sewer lines 6 Seepage pit 9 Feedyard 13 Insecticide storage Direction from well? Southwest How many feet? 200									
FROM TO LITHOLOGIC LOG FROM TO PLUGGING INTERVALS									
0 3 topsoil									
3 16 clay									
16 65 brown shale									
7 CONTRACTOR'S OR LANDOWNER'S CERTIFICATION: This water well was (1) constructed, (2) reconstructed, or (3) plugged under my jurisdiction and was completed on (mo/day/year) 01/20/1995 and this record is true to the best of my knowledge and belief. Kansas Water Well Contractor's License No. 236 This Water Well Record was completed on (mo/day/yr) 01/24/95 Under the business name of Harp Well & Pump Service, Inc. by (signature) Jane Frederick									