

CORRECTION TO WATER WELL RECORD (WWC-5)

The following correction(s) was made to the attached WWC-5 log in order to rectify lacking or incorrect information.

Fraction (1/4 1/4 1/4) Section-Township-Range changed:

listed as 2-285-25

changed to NE SW, 2-285-25E

Other changes: Initial statements: _____

Changed to: _____

Comments: _____

verification method: Phone call to Burns & McDonnell, written & legal descriptions, and Cato 1:24,000 topo. map.

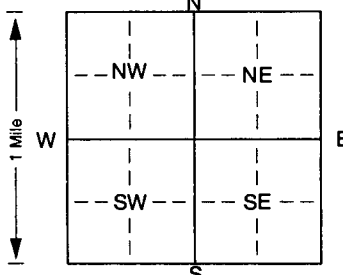
initials: DRD date: 2/4/2003

submitted by: Kansas Geological Survey, Data Resources Library, 1930 Constant Ave., Lawrence, KS 66047-3726
to: Kansas Dept of Health & Environment Bureau of Water Industrial Programs, Bldg 283, Forbes Field, KS 66620

1 LOCATION OF WATER WELL: Fraction $\frac{1}{4}$ $\frac{1}{4}$ $\frac{1}{4}$ Section Number 2 Township Number T 28 S R 25 E/W

Distance and direction from nearest town or city street address of well if located within city?
1/2 MILE WEST OF ARCADIA, KS

2 WATER WELL OWNER: OAK GROVE SANITARY LANDFILL % BURNS + McDONNELL
 RR#, St. Address, Box #: 9400 WARD PKWY Board of Agriculture, Division of Water Resources
 City, State, ZIP Code: KANSAS CITY, MO 64114 Application Number:

3 LOCATE WELL'S LOCATION WITH AN "X" IN SECTION BOX:

 4 DEPTH OF COMPLETED WELL: 37.6 ft. ELEVATION: 837.5
 Depth(s) Groundwater Encountered 1. 19.9 ft. 2. ft. 3. ft.
 WELL'S STATIC WATER LEVEL: 21.08 ft. below land surface measured on mo/day/yr 9/10/01
 Pump test data: Well water was ft. after hours pumping gpm
 Est. Yield gpm: Well water was ft. after hours pumping gpm
 Bore Hole Diameter: 6 in. to 37.6 ft., and in. to ft.
 WELL WATER TO BE USED AS: 5 Public water supply 8 Air conditioning 11 Injection well
 1 Domestic 3 Feedlot 6 Oil field water supply 9 Dewatering 12 Other (Specify below)
 2 Irrigation 4 Industrial 7 Domestic (lawn & garden) 10 Monitoring well
 Was a chemical/bacteriological sample submitted to Department? Yes. No. X; If yes, mo/day/yr sample was submitted
 Water Well Disinfected? Yes No

5 TYPE OF BLANK CASING USED:
 1 Steel PVC 3 RMP (SR) 4 ABS 5 Wrought iron 6 Asbestos-Cement 7 Fiberglass 8 Concrete tile 9 Other (specify below) CASING JOINTS: Glued. Clamped. Welded. Threaded. X
 Blank casing diameter 2 in. to ft., Dia in. to ft., Dia in. to ft.
 Casing height above land surface 2.59 in., weight lbs./ft. Wall thickness or gauge No. Set 40
 TYPE OF SCREEN OR PERFORATION MATERIAL: 7 PVC 10 Asbestos-cement 11 Other (specify) 12 None used (open hole)
 1 Steel 3 Stainless steel 5 Fiberglass 8 RMP (SR) 9 ABS
 2 Brass 4 Galvanized steel 6 Concrete tile
 SCREEN OR PERFORATION OPENINGS ARE:
 1 Continuous slot 3 Mill slot 5 Gauzed wrapped 8 Saw cut 11 None (open hole)
 2 Louvered shutter 4 Key punched 6 Wire wrapped 9 Drilled holes
 7 Torch cut 10 Other (specify) ft.
 SCREEN-PERFORATED INTERVALS: From 32.4 ft. to 37.4 ft., From ft. to ft.
 From ft. to ft., From ft. to ft.
 GRAVEL PACK INTERVALS: From 30 ft. to 37.6 ft., From ft. to ft.
 From ft. to ft., From ft. to ft.

6 GROUT MATERIAL: 1 Neat cement 2 Cement grout 3 Bentonite 4 Other
 Grout Intervals: From 3 ft. to 30 ft., From ft. to ft., From ft. to ft.
 What is the nearest source of possible contamination:
 1 Septic tank 4 Lateral lines 7 Pit privy 10 Livestock pens 14 Abandoned water well
 2 Sewer lines 5 Cess pool 8 Sewage lagoon 11 Fuel storage 15 Oil well/Gas well
 3 Watertight sewer lines 6 Seepage pit 9 Feedyard 12 Fertilizer storage 16 Other (specify below)
 LANDFILL
 13 Insecticide storage
 Direction from well? How many feet?

FROM	TO	LITHOLOGIC LOG	FROM	TO	PLUGGING INTERVALS
0	14.9	FILL			
14.9	20.3	CLAY			
20.3	24	SHALE			
24	32.5	CLAYSTONE			
32.5	34	SANDSTONE			
34	38.8	SHALE			
38.8	39.2	MIDSTONE			

7 CONTRACTOR'S OR LANDOWNER'S CERTIFICATION: This water well was (1) constructed, (2) reconstructed, or (3) plugged under my jurisdiction and was completed on (mo/day/year) 9/10/01 and this record is true to the best of my knowledge and belief. Kansas Water Well Contractor's Licence No. 568 This Water Well Record was completed on (mo/day/yr) 11/5/01 under the business name of MAX'S ENTERPRISES by (signature) David Chung