


1 LOCATION OF WATER WELL: County: CRAWFORD	Fraction $\frac{1}{4}$ $\frac{1}{4}$ NW $\frac{1}{4}$	Section Number 2	Township Number T 28 S	Range Number R 25 EW
--	---	----------------------------	----------------------------------	---------------------------------------

Distance and direction from nearest town or city street address of well if located within city?
Well #97-3 @ Oak Grove SLF near Arcadia KS

2 WATER WELL OWNER: **USA Waste 40 Burns & McDonnell**
 RR#, St. Address, Box #: **9400 Ward Parkway**
 City, State, ZIP Code: **Kansas City MO 64114**
 Board of Agriculture, Division of Water Resources
 Application Number:

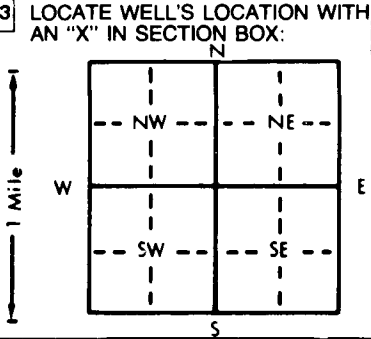

4 DEPTH OF COMPLETED WELL: **77.4** ft. ELEVATION: _____ ft.

Depth(s) Groundwater Encountered 1. _____ ft. 2. _____ ft. 3. _____ ft.

WELL'S STATIC WATER LEVEL _____ ft. below land surface measured on mo/day/yr

Pump test data: Well water was _____ ft. after _____ hours pumping _____ gpm

Est. Yield _____ gpm; Well water was _____ ft. after _____ hours pumping _____ gpm

Bore Hole Diameter: **8 1/4** in. to **54.3** ft., and **6** in. to **77.4** ft.

WELL WATER TO BE USED AS:

5 Public water supply	8 Air conditioning	11 Injection well
1 Domestic	3 Feedlot	6 Oil field water supply
2 Irrigation	4 Industrial	7 Lawn and garden only
		<input checked="" type="checkbox"/> 10 Monitoring well

Was a chemical/bacteriological sample submitted to Department? Yes _____ No If yes, mo/day/yr sample was submitted

Water Well Disinfected? Yes _____ No

5 TYPE OF CASING USED:

1 Steel	3 RMP (SR)	5 Wrought iron	8 Concrete tile	CASING JOINTS: Glued _____ Clamped _____
<input checked="" type="checkbox"/> 2 PVC	4 ABS	6 Asbestos-Cement	9 Other (specify below)	Welded _____
		7 Fiberglass		Threaded <input checked="" type="checkbox"/>

Blank casing diameter: **2** in. to **72** ft., Dia _____ in. to _____ ft., Dia _____ in. to _____ ft.

Casing height above land surface: **36** in., weight _____ lbs./ft. Wall thickness or gauge No. **Sch 40**

TYPE OF SCREEN OR PERFORATION MATERIAL:

1 Steel	3 Stainless steel	5 Fiberglass	8 RMP (SR)	10 Asbestos-cement
2 Brass	4 Galvanized steel	6 Concrete tile	9 ABS	11 Other (specify) _____
				12 None used (open hole)

SCREEN OR PERFORATION OPENINGS ARE:

1 Continuous slot	<input checked="" type="checkbox"/> 3 Mill slot	5 Gauzed wrapped	8 Saw cut	11 None (open hole)
2 Louvered shutter	4 Key punched	6 Wire wrapped	9 Drilled holes	
		7 Torch cut	10 Other (specify) _____	

SCREEN-PERFORATED INTERVALS: From **72** ft. to **77** ft., From _____ ft. to _____ ft.

GRAVEL PACK INTERVALS: From **70** ft. to **77.4** ft., From _____ ft. to _____ ft.

6 GROUT MATERIAL: 1 Neat cement 2 Cement grout 3 Bentonite 4 Other _____

Grout Intervals: From **2** ft. to **70** ft., From _____ ft. to _____ ft., From _____ ft. to _____ ft.

What is the nearest source of possible contamination:

1 Septic tank	4 Lateral lines	7 Pit privy	10 Livestock pens	14 Abandoned water well
2 Sewer lines	5 Cess pool	8 Sewage lagoon	11 Fuel storage	15 Oil well/Gas well
3 Watertight sewer lines	6 Seepage pit	9 Feedyard	12 Fertilizer storage	<input checked="" type="checkbox"/> 16 Other (specify below)
			13 Insecticide storage	Landfill

Direction from well? _____ How many feet? _____

FROM	TO	LITHOLOGIC LOG	FROM	TO	PLUGGING INTERVALS
0	54.3	Mine waste			
54.3	77.4	Interbedded shale, limestone, coal, sandstone			

7 CONTRACTOR'S OR LANDOWNER'S CERTIFICATION: This water well was (1) constructed, (2) reconstructed, or (3) plugged under my jurisdiction and was completed on (mo/day/year) **12.17.97** and this record is true to the best of my knowledge and belief. Kansas Water Well Contractor's License No. **370** This Water Well Record was completed on (mo/day/yr) **2.9.98** under the business name of **AQUADRILL, INC.** by (signature) **Diane Doherty**

INSTRUCTIONS: Use typewriter or ball point pen. PLEASE PRESS FIRMLY and PRINT clearly. Please fill in blanks, underline or circle the correct answers. Send top three copies to Kansas Department of Health and Environment, Bureau of Water, Topeka, Kansas 66620-0001. Telephone: 913-296-5545. Send one to WATER WELL OWNER and retain one for your records.

OFFICE USE ONLY
T
R
EW
SEC.
1/4
1/4
1/4