


1 LOCATION OF WATER WELL: County: Crawford Fraction SW 1/4 SW 1/4 NE 1/4 Section Number 28 Township Number T 28 S Range Number R 25 EW

Distance and direction from nearest town or city street address of well if located within city? 2 1/2 miles north of Mulberry, Kansas

2 WATER WELL OWNER: Clemens Coal Company RR#, St. Address, Box #: P.O. Box 299 City, State, ZIP Code: Pittsburg, Kansas 66762 Board of Agriculture, Division of Water Resources Application Number:

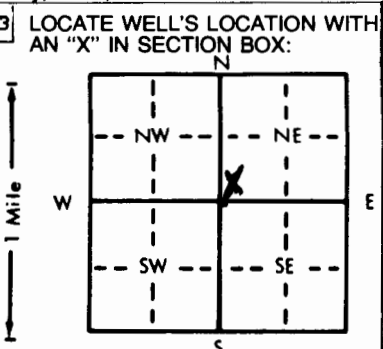

3 LOCATE WELL'S LOCATION WITH AN 'X' IN SECTION BOX: 4 DEPTH OF COMPLETED WELL: 14 ft. ELEVATION: 851.0. WELL'S STATIC WATER LEVEL: 5 ft. below land surface measured on 4/19/86. Pump test data: Well water was N/A ft. after hours pumping gpm. Est. Yield: gpm: Well water was ft. after hours pumping gpm. Bore Hole Diameter: 4 in. to 14 ft., and in. to ft. WELL WATER TO BE USED AS: 5 Public water supply 8 Air conditioning 11 Injection well 1 Domestic 3 Feedlot 6 Oil field water supply 9 Dewatering 12 Other (Specify below) 2 Irrigation 4 Industrial 7 Lawn and garden only 10 Observation well. Was a chemical/bacteriological sample submitted to Department? Yes No X; If yes, mo/day/yr sample was submitted Water Well Disinfected? Yes No

5 TYPE OF BLANK CASING USED: 1 Steel 3 RMP (SR) 5 Wrought iron 8 Concrete tile CASING JOINTS: Glued X Clamped 2 PVC 4 ABS 6 Asbestos-Cement 9 Other (specify below) Welded Threading. Blank casing diameter: 1 in. to 2.5 ft., Dia. in. to ft., Dia. in. to ft. Casing height above land surface: 20 in., weight Sch. 40 lbs./ft. Wall thickness or gauge No.

TYPE OF SCREEN OR PERFORATION MATERIAL: 1 Steel 3 Stainless steel 5 Fiberglass 8 RMP (SR) 10 Asbestos-cement 2 Brass 4 Galvanized steel 6 Concrete tile 9 ABS 11 Other (specify) 12 None used (open hole)

SCREEN OR PERFORATION OPENINGS ARE: 1 Continuous slot 3 Mill slot 5 Gauzed wrapped 8 Saw cut 11 None (open hole) 2 Louvered shutter 4 Key punched 6 Wire wrapped 9 Drilled holes 10 Other (specify) 7 Torch cut

SCREEN-PERFORATED INTERVALS: From 9 ft. to 14 ft., From ft. to ft. GRAVEL PACK INTERVALS: From 3 ft. to 14 ft., From ft. to ft.

6 GROUT MATERIAL: 1 Neat cement 2 Cement grout 3 Bentonite 4 Other Grout intervals: From 0 ft. to 2.5 ft., From 2.5 ft. to 3.0 ft., From ft. to ft.

What is the nearest source of possible contamination: 1 Septic tank 4 Lateral lines 7 Pit privy 10 Livestock pens 14 Abandoned water well 2 Sewer lines 5 Cess pool 8 Sewage lagoon 11 Fuel storage 15 Oil well/Gas well 3 Watertight sewer lines 6 Seepage pit 9 Feedyard 12 Fertilizer storage 16 Other (specify below) 13 Insecticide storage Coal Spoil Piles

Direction from well? How many feet?

Table with columns: FROM, TO, LITHOLOGIC LOG. Row 1: FROM 0 TO 14 LITHOLOGIC LOG Shale Fill.

7 CONTRACTOR'S OR LANDOWNER'S CERTIFICATION: This water well was (1) constructed, (2) reconstructed, or (3) plugged under my jurisdiction and was completed on (mo/day/year) 4/17/86 and this record is true to the best of my knowledge and belief. Kansas Water Well Contractor's License No. 399 This Water Well Record was completed on (mo/day/yr) 6/3/86 under the business name of Woodward-Clyde Consultants by signature Richard L. Woodward INSTRUCTIONS: Use typewriter or ball point pen, PLEASE PRESS FIRMLY and PRINT clearly. Please fill in blanks, underline or circle the correct answers. Send top three copies to Kansas Department of Health and Environment, Division of Environment, Environmental Geology Section, Topeka, KS 66620. Send one to WATER WELL OWNER and retain one for your records.