


1 LOCATION OF WATER WELL: Fraction SE 1/4 NE 1/4 SW 1/4 Section Number 2 Township Number T 28 S Range Number R 25 E

Distance and direction from nearest town or city street address of well if located within city?
1/2 mi west of Arcadia, KS

2 WATER WELL OWNER: Deffenbaugh Industries, Inc.
 RR#, St. Address, Box # : 18181 W 53rd Board of Agriculture, Division of Water Resources
 City, State, ZIP Code : Shawnee, KS 66217 Application Number:

3 LOCATE WELL'S LOCATION WITH AN "X" IN SECTION BOX:

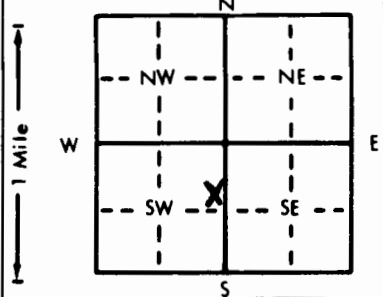

4 DEPTH OF COMPLETED WELL 19.5 ft. ELEVATION: _____
 Depth(s) Groundwater Encountered _____ ft. 2. _____ ft. 3. _____ ft.
 WELL'S STATIC WATER LEVEL 7.64 ft. below land surface measured on mo/day/yr 2-28-95
 Pump test data: Well water was _____ ft. after _____ hours pumping _____ gpm
 Est. Yield _____ gpm: Well water was _____ ft. after _____ hours pumping _____ gpm
 Bore Hole Diameter 7 3/8 in. to 19.5 ft., and _____ in. to _____ ft.
 WELL WATER TO BE USED AS: 5 Public water supply 8 Air conditioning 11 Injection well
 1 Domestic 3 Feedlot 6 Oil field water supply 9 Dewatering 12 Other (Specify below)
 2 Irrigation 4 Industrial 7 Lawn and garden only 10 Monitoring well MW 24-Base of Underlay
 Was a chemical/bacteriological sample submitted to Department? Yes _____ No X; If yes, mo/day/yr sample was submitted
 Water Well Disinfected? Yes _____ No X

5 TYPE OF BLANK CASING USED: 5 Wrought iron 8 Concrete tile CASING JOINTS: Glued _____ Clamped _____
 1 Steel 3 RMP (SR) 6 Asbestos-Cement 9 Other (specify below) Welded _____
2 PVC 4 ABS 7 Fiberglass _____ Threaded X

Blank casing diameter 2 in. to 16.5 ft., Dia _____ in. to _____ ft., Dia _____ in. to _____ ft.
 Casing height above land surface 36 in., weight _____ lbs./ft. Wall thickness or gauge No. 3ch 40

TYPE OF SCREEN OR PERFORATION MATERIAL: 2 PVC 10 Asbestos-cement
 1 Steel 3 Stainless steel 5 Fiberglass 8 RMP (SR) 11 Other (specify) _____
 2 Brass 4 Galvanized steel 6 Concrete tile 9 ABS 12 None used (open hole)

SCREEN OR PERFORATION OPENINGS ARE: 5 Gauzed wrapped 8 Saw cut 11 None (open hole)
 1 Continuous slot 3 Mill slot 6 Wire wrapped 9 Drilled holes
 2 Louvered shutter 4 Key punched 7 Torch cut 10 Other (specify) _____

SCREEN-PERFORATED INTERVALS: From 16.5 ft. to 19.5 ft., From _____ ft. to _____ ft.
 From _____ ft. to _____ ft., From _____ ft. to _____ ft.
 GRAVEL PACK INTERVALS: From 14.5 ft. to 19.5 ft., From _____ ft. to _____ ft.
 From _____ ft. to _____ ft., From _____ ft. to _____ ft.

6 GROUT MATERIAL: 1 Neat cement 2 Cement grout 3 Bentonite 4 Other _____
 Grout Intervals: From 2 ft. to 12 ft., From 12 ft. to 14.50 ft., From _____ ft. to _____ ft.

What is the nearest source of possible contamination:
 1 Septic tank 4 Lateral lines 7 Pit privy 10 Livestock pens 14 Abandoned water well
 2 Sewer lines 5 Cess pool 8 Sewage lagoon 11 Fuel storage 15 Oil well/Gas well
 3 Watertight sewer lines 6 Seepage pit 9 Feedyard 12 Fertilizer storage 16 Other (specify below)
 13 Insecticide storage MSWLF
 Direction from well? WEST How many feet? 492

FROM	TO	LITHOLOGIC LOG	FROM	TO	PLUGGING INTERVALS
0	6.5	CLAY, silty, dk-brown, moist, soft, some roots			
6.5	11.3	CLAY, gray, mottled w/orange, soft, moist plastic, thin med. sand, fine gravel (w/leath shale)			
11.3	11.5	COAL, black, (Wes-Pittsburg)			
11.5	16.5	UNDERLAY, gray, soft, fine weath, Fe stained			
16.5	19.5	SHALE, gray, w/orange, Fe staining, soft, weathered, moist			

7 CONTRACTOR'S OR LANDOWNER'S CERTIFICATION: This water well was (1) constructed, (2) reconstructed, or (3) plugged under my jurisdiction and was completed on (mo/day/year) 2-15-94 and this record is true to the best of my knowledge and belief. Kansas Water Well Contractor's License No. 483 This Water Well Record was completed on (mo/day/yr) 2-29-95 under the business name of T.B.S.T. by (signature) Dan R. Snyers

OFFICE USE ONLY
T 28 S R 25 E
SEC. 2
SE 1/4 NE 1/4 SW 1/4