


1 LOCATION OF WATER WELL:		Fraction	Section Number	Township Number	Range Number
County:	Butler	SE 1/4 SE 1/4 5 1/4	36	T 28 S	R 3 E/W

Distance and direction from nearest town or city street address of well if located within city?

2	WATER WELL OWNER:	Jason Bell	
	RR#, St. Address, Box # :	400 W. Central, #3703	Board of Agriculture, Division of Water Resources
	City, State, ZIP Code :	Wichita, KS 67203	Application Number:

3 LOCATE WELL'S LOCATION WITH AN "X" IN SECTION BOX: 4 DEPTH OF COMPLETED WELL... 140 ft. ELEVATION:

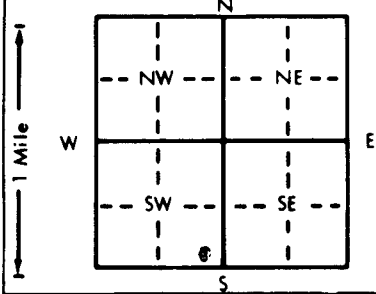

4 DEPTH OF COMPLETED WELL 140 ft. ELEVATION: _____

Depth(s) Groundwater Encountered 1 ft. 2 ft. 3 ft.

WELL'S STATIC WATER LEVEL 50 ft. below land surface measured on mo/day/yr 6-6-00

Pump test data: Well water was _____ ft. after _____ hours pumping _____ gpm

Est. Yield _____ gpm Well water was _____ ft. after _____ hours pumping _____ gpm

Bore Hole Diameter 9 in. to 140 ft., and _____ in. to _____ ft.

WELL WATER TO BE USED AS:

1 Domestic	3 Feedlot	6 Oil field water supply	8 Air conditioning	11 Injection well
2 Irrigation	4 Industrial	7 Lawn and garden only	9 Dewatering	12 Other (Specify below)
			10 Monitoring well	

Was a chemical/bacteriological sample submitted to Department? Yes _____ No X; if yes, mo/day/yr sample was submitted _____

Water Well Disinfected? Yes X No _____

5 TYPE OF BLANK CASING USED:		3 Wrought iron		8 Concrete tile		CASING JOINTS: Glued ☒ Clamped ☒	
1 Steel		6 Asbestos-Cement		9 Other (specify below)		Welded	
② PVC		7 Fiberglass				Threaded	
17 Blank casing diameter		17 5 in. to 120 ft., Dia		17 in. to 17 ft., Dia		17 in. to 17 ft.	
17 Casing height above land surface		17 12 in., weight		17 lbs./ft. Wall thickness or gauge No.		17 5DR26	
TYPE OF SCREEN OR PERFORATION MATERIAL:				⑦ PVC		10 Asbestos-cement	
1 Steel		3 Stainless steel		8 RMP (SR)		11 Other (specify)	
2 Brass		4 Galvanized steel		9 ABS		12 None used (open hole)	
3 Fiberglass		6 Concrete tile					
SCREEN OR PERFORATION OPENINGS ARE:				5 Gauzed wrapped		8 Saw cut	
1 Continuous slot		③ Mill slot		6 Wire wrapped		11 None (open hole)	
2 Louvered shutter		4 Key punched		7 Torch cut		9 Drilled holes	
				10 Other (specify)			
SCREEN-PERFORATED INTERVALS:				From 120 ft. to 140 ft., From		ft. to ft.	
				From ft. to ft., From		ft. to ft.	
GRAVEL PACK INTERVALS:				From 20 ft. to 140 ft., From		ft. to ft.	
				From ft. to ft., From		ft. to ft.	

6 GROUT MATERIAL: 1 Neat cement 2 Cement grout 3 Bentonite 4 Other
Grout Intervals: From 4 ft. to 20 ft., From ft. to ft., From ft. to ft.
What is the nearest source of possible contamination:
1 Septic tank 4 Lateral lines 7 Pit privy 10 Livestock pens 14 Abandoned water well
2 Sewer lines 5 Cess pool 8 Sewage lagoon 11 Fuel storage 15 Oil well/Gas well
3 Watertight sewer lines 6 Seepage pit 9 Feedyard 12 Fertilizer storage 16 Other (specify below)
13 Insecticide storage
Direction from well? How many feet?

[illegible]

7 CONTRACTOR'S OR LANDOWNER'S CERTIFICATION: This water well was (1) constructed, (2) reconstructed, or (3) plugged under my jurisdiction and was completed on (mo/day/year) 6-6-00 and this record is true to the best of my knowledge and belief. Kansas Water Well Contractor's License No. 171 This Water Well Record was completed on (mo/day/yr) 6-20-00 under the business name of G+S Drilling, Inc. by (signature) [Signature]