WATER WELL RECORD Form WWC-5 KSA 82a-1212

1 LOCATION OF WATER WELL:

County:	Fraction	Section Number	Township Number	Range Number
BUTLER	NW ¼ SW ¼ NW ¼	5	T 28 S	R 3 E

Distance and direction from nearest town or city street address of well if located within city?
101 E BERRY

2 WATER WELL OWNER: MIDTOWN SERV DICK SHOWALTER
RR#, St. Address, Box # : PO BOX 23
City, State, ZIP Code : ROSE HILL KS 67133

Board of Agriculture, Division of Water Resources
Application Number:

3 LOCATE WELL'S LOCATON WITH AN "X" IN SECTION BOX:

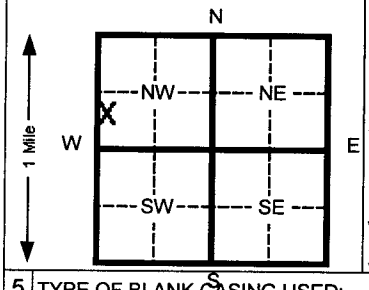

4 DEPTH OF COMPLETED WELL 40 ft. ELEVATION:
Depth(s) Groundwater Encountered 1 NA ft. 2 ft. 3 Ft.
WELL'S STATIC WATER LEVEL 28.55 ft. below land surface measured on mo/day/yr 2/14/01
Pump test data: Well water was Ft. after hours pumping Gpm
Est. Yield Gpm: Well water was Ft. after Hours pumping Gpm
Bore Hole Diameter 8.625 In. to 40 ft. and in. to Ft.
WELL WATER TO BE USED AS: 1 Domestic 3 Feed lot 5 Public water supply 6 Oil field water supply 7 Lawn and garden (domestic) 8 Air conditioning 9 Dewatering 10 Monitoring well 11 Injection well 12 Other (Specify below) MW-12
2 Irrigation 4 Industrial
Was a chemical/bacteriological sample submitted to Department? Yes No X If yes, mo/day/yr sample was Submitted
Water Well Disinfected? Yes No X

5 TYPE OF BLANK CASING USED:
1 Steel 3 RMP (SR) 5 Wrought Iron 8 Concrete tile
2 PVC 4 ABS 6 Asbestos-Cement 9 Other (specify below)
7 Fiberglass
CASING JOINTS: Glued Clamped Welded Threaded X
Blank casing diameter 2 in. to 20 Ft., Dia In. to ft., Dia in. to ft.
Casing height above land surface FLUSH in., weight SCH 40 Lbs./ft. Wall thickness or gauge No.
TYPE OF SCREEN OR PERFORATION MATERIAL:
1 Steel 3 Stainless steel 5 Fiberglass 7 PVC 10 Asbestos-cement
2 Brass 4 Galvanized steel 6 Concrete tile 8 RMP (SR) 11 Other (specify)
9 ABS 12 None used (open hole)
SCREEN OR PERFORATION OPENINGS ARE:
1 Continuous slot 3 Mill slot 5 Gauzed wrapped 8 Saw cut 11 None (open hole)
2 Louvered shutter 4 Key punched 6 Wire wrapped 9 Drilled holes
7 Torch cut 10 Other (specify)
SCREEN-PERFORATED INTERVALS: From 20 ft. to 40 ft. From ft. to ft.
From ft. to ft. From ft. to Ft.
SAND PACK INTERVALS: From 19 ft. to 40 ft. From ft. to Ft.
From ft. to ft. From ft. to Ft.

6 GROUT MATERIAL: 1 Neat cement 2 Cement grout 3 Bentonite 4 Other
Grout Intervals From3 17 ft. to 19 Ft. From2 17 Ft. to 3 ft. From ft. to ft.
What is the nearest source of possible contamination:
1 Septic tank 4 Lateral lines 7 Pit privy 10 Livestock pens 14 Abandoned water well
2 Sewer lines 5 Cess pool 8 Sewage lagoon 11 Fuel storage 15 Oil well/ Gas well
3 Watertight sewer lines 6 Seepage pit 9 Feedyard 12 Fertilizer storage 16 Other (specify below) Contaminated Site
13 Insecticide storage
Direction from well? How many feet?

FROM	TO	CODE	LITHOLOGIC LOG	FROM	TO	PLUGGING INTERVALS
0	.5		CONCRETE			
.5	7		CLAY W SOME SILT			
7	13		SILTY CLAY			
13	31		MUDSTONE			
31	31.5		LIMESTONE			
31.5	40		MUDSTONE			
40	TD		END OF BOREHOLE			

7 CONTRACTOR'S OR LANDOWNER'S CERTIFICATION: This water well was (x) constructed, (2) reconstructed, or (3) plugged under my jurisdiction and w
Completed on (mo/day/yr) 1/25/01 And this record is true to the best of my knowledge and belief. Kansas
Water Well Contractor's License No. 585 This Water Well Record was completed on (mo/day/yr) 02/22/01
under the business name of Associated Environmental, Inc. By (signature) Darin R Duncan

INSTRUCTIONS:. Please fill in blanks and circle the correct answers. Send three copies to Kansas Department of Health and Environment, Bureau of Water, Topeka, Kansas 66620-0001. Telephone: 913-296-5545. Send one to WATER WELL OWNER and retain one for your records.`