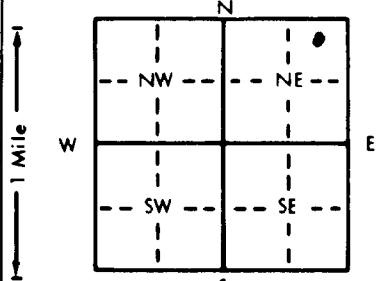


1 LOCATION OF WATER WELL: County: <u>Butler</u>	Fraction <u>NE 1/4 NE 1/4 NE 1/4</u>	Section Number <u>24</u>	Township Number T <u>28</u> S	Range Number R <u>3E</u> E/W
--	---	-----------------------------	----------------------------------	---------------------------------

Distance and direction from nearest town or city street address of well if located within city?

17127 SW Tawakoni Rd, Rose Hill, KS

2 WATER WELL OWNER: <u>Mark Hokeness</u> RR#, St. Address, Box #: <u>17127 SW Tawakoni Rd,</u> City, State, ZIP Code: <u>Rose Hill, KS 67133</u>	Board of Agriculture, Division of Water Resources Application Number:
--	--


--	---

5 TYPE OF BLANK CASING USED: 1 Steel 3 RMP (SR) 5 Wrought iron 8 Concrete tile ② PVC 4 ABS 6 Asbestos-Cement 9 Other (specify below) Blank casing diameter <u>5</u> in. to <u>75</u> ft. Dia <u>5</u> in. to <u>75</u> ft. Dia <u>5</u> in. to <u>75</u> ft. Casing height above land surface <u>12</u> in. weight <u>12</u> lbs./ft. Wall thickness or gauge No. <u>SDR26</u> TYPE OF SCREEN OR PERFORATION MATERIAL: 1 Steel 3 Stainless steel 5 Fiberglass ⑦ PVC 10 Asbestos-cement 2 Brass 4 Galvanized steel 6 Concrete tile 8 RMP (SR) 11 Other (specify) 12 None used (open hole) SCREEN OR PERFORATION OPENINGS ARE: 1 Continuous slot ③ Mill slot 5 Gauzed wrapped 8 Saw cut 11 None (open hole) 2 Louvered shutter 4 Key punched 6 Wire wrapped 9 Drilled holes SCREEN-PERFORATED INTERVALS: From <u>75</u> ft. to <u>95</u> ft. 
--

well 3 Watertight sewer lines 6 Seepage pit 9 Feedyard 12 Fertilizer storage 16 Other (specify below) 13 Insecticide storage Direction from well? How many feet?
--

FROM	TO	LITHOLOGIC LOG	FROM	TO	PLUGGING INTERVALS
0	15	clay			
15	24	shale			
24	30	lime			
30	46	shale			
46	65	shale w/ lime str			
65	95	clayey lime			

7 CONTRACTOR'S OR LANDOWNER'S CERTIFICATION: This water well was ① constructed, (2) reconstructed, or (3) plugged under my jurisdiction and was completed on (mo/day/year) <u>3-22-01</u> and this record is true to the best of my knowledge and belief. Kansas Water Well Contractor's License No. <u>171</u> This Water Well Record was completed on (mo/day/yr) <u>4-13-01</u> under the business name of <u>G & S Drilling Inc.</u> by (signature) <u>[Signature]</u>
--