

1	LOCATION OF WATER WELL:	Fraction	Section Number	Township Number	Range Number
County:	Butler	5 th 1/4 NW 1/4 NW 1/4	5	T 28 S	R 3 E

Distance and direction from nearest town or city street address of well if located within city?

2 1/4 Miles South of 400 Hwy on Southwest Butler Rd


2 WATER WELL OWNER: Flint Hills Co LC

RR#, St. Address, Box # : P.O. Box 782170
City, State, ZIP Code : Wichita, KS 67278

Board of Agriculture, Division of Water Resources
Application Number:

3	LOCATE WELL'S LOCATION WITH	4	DEPTH OF COMPLETED WELL 65 ft. ELEVATION:
---	-----------------------------	---	---

AN "X" IN SECTION BOX:

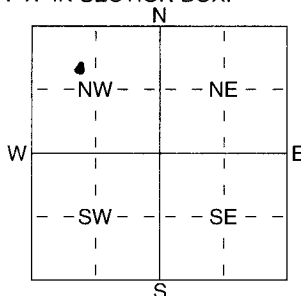

Depth(s) Groundwater Encountered 1 48 ft. 2 _____ ft. 3 _____ ft.
WELL'S STATIC WATER LEVEL 33 ft. below land surface measured on mo/day/yr 4-5-01

Pump test data:	Well water was	 ft. after	 hours pumping	 gpm
Est. Yield <u>25</u> gpm:	Well water was	 ft. after	 hours pumping	 gpm

WELL WATER TO BE USED AS:

1 Domestic	3 Feedlot	5 Public water supply	8 Air conditioning	11 Injection well
2 Irrigation	4 Industrial	6 Oil field water supply	9 Dewatering	12 Other (Specify below)
		7 Domestic (lawn & garden)	10 Monitoring well	

Was a chemical/bacteriological sample submitted to Department? Yes No ☒ ; If yes, mo/day/yr sample was submitted

Water Well Disinfected? Yes ☒ No ☐

5	TYPE OF BLANK CASING USED:
---	----------------------------

5 Wrought iron

8 Concrete tile

CASING JOINTS: Glued ☒ Clamped ☐

1 Steel	3 RMP (SR)
2 PVC	4 ABS

6 Asbestos-Cement
7 Fiberglass

9 Other (specify below)

Welded

Blank casing diameter 5 in. to 45 ft. Dia 5 in. to 45 ft. Dia 5 in. to 45 ft.

Casing height above land surface 18 in., weight 50R26 lbs./ft. Wall thickness or guage No.

TYPE OF SCREEN OR PERFORATION MATERIAL:

1 Steel	3 Stainless Steel
2 Brass	4 Galvanized Steel

5 Fiberglass
6 Concrete tile

7 PVC
8 RMP (SR)
9 ABS

10 Asbestos-Cement
11 Other (Specify)
12 None used (open hole)

SCREEN OR PERFORATION OPENINGS ARE:

1 Continuous slot
2 Louvered shutter
3 Mill slot
4 Key punched

5 Guazed wrapped
6 Wire wrapped
7 Torch cut

8 Saw cut
9 Drilled holes
10 Other (specify) ft.
11 None (open hole)

SCREEN-PERFORATED INTERVALS: From 45 ft. to 65 ft., From _____ ft. to _____ ft.

From 75 ft. to 85 ft., From _____ ft. to _____ ft.

GRAVEL PACK INTERVALS: From 23 ft. to 65 ft., From ft. to ft.
From ft. to ft., From ft. to ft.

6 GROUT MATERIAL: 1 Neat cement 2 Cement grout 3 Bentonite 4 Other

Grout Intervals: From 3 ft. to 23 ft., From _____ ft. to _____ ft., From _____ ft. to _____ ft.

What is the nearest source of possible contamination:

1 Septic tank	4 Lateral lines	7 Pit privy	11 Fuel storage	15 Oil well/Gas well
2 Sewer lines	5 Cess pool	8 Sewage lagoon	12 Fertilizer storage	16 Other (specify below)
3 Watertight sewer lines	6 Seepage pit	9 Feedyard	13 Insecticide storage	<u>Slur AREA</u>

Direction from well? W How many feet? 150

[illegible]

7. CONTRACTOR'S OR LANDOWNER'S CERTIFICATION: This water well was (1) constructed, (2) reconstructed, or (3) plugged under my jurisdiction and was completed on (mo/day/year) 4-5-01 and this record is true to the best of my knowledge and belief. Kansas

Water Well Contractor's Licence No. 464 This Water Well Record was completed on (mo/day/yr) 05/30/02
under the business name of 1. WATER WELL SERVICES by (signature) [Signature]