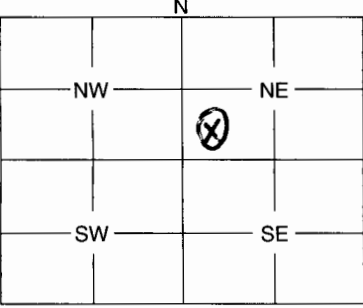


1	LOCATION OF WATER WELL:	Fraction	Section Number	Township Number	Range Number
County: BUTLER		SW 1/4 NE 1/4 1/4	24	PLEASANT 28	3 E E/W
Distance and direction from nearest town or city street address of well if located within city?					

2	WATER WELL OWNER: GEORGE COLEMAN 15439 MILLVIEW	
RR #, St. Address, Box #:		Board of Agriculture, Division of Water Resources
City, State, ZIP Code : AUGUSTA, KS 67010		Application Number:

3	MARK WELL'S LOCATION WITH AN "X" IN SECTION BOX:	4	DEPTH OF WELL 97 ft. WELL'S STATIC WATER LEVEL 70 ft. WELL WAS USED AS: ☒ 1 Domestic ☐ 2 Irrigation ☐ 3 Feedlot ☐ 4 Industrial ☐ 5 Public Water Supply ☐ 6 Oil Field Water Supply ☐ 7 Domestic (Lawn & Garden) ☐ 8 Air Conditioning ☐ 9 Dewatering ☐ 10 Monitoring Well ☐ 11 Injection Well ☐ 12 Other
		Was a chemical / bacteriological sample submitted to Department? Yes No X If yes, mo/day/yr sample was submitted Water Well Disinfected: Yes X No	

5	TYPE OF BLANK CASING USED:	
1 Steel 3 RMP (SR) 5 Wrought 7 Fiberglass 9 Other (Specify below) 2 PVC 4 ABS 6 Asbestos-Cement 8 Concrete Tile		
Blank casing diameter in. Was casing pulled? Yes No X If yes, how much Casing height above or <u>below</u> land surface 12 in.		

6	GROUT PLUG MATERIAL: 1 Neat cement 2 Cement grout 3 Bentonite 4 Other	
Grout Plug Intervals: From ft. to ft., From ft. to ft., From to ft.		
What is the nearest source of possible contamination: 1 Septic tank 6 Seepage pit 11 Fuel storage 16 Other (specify below) 2 Sewer lines 7 Pit privy 12 Fertilizer storage 3 Watertight sewer lines 8 Sewage lagoon 13 Insecticide storage 4 Lateral lines 9 Feedyard 14 Abandoned water well 5 Cess pool 10 Livestock pens 15 Oil well/Gas well		
Direction from well? How many feet?		

FROM	TO	PLUGGING MATERIALS
97'	9'	BENTONITE
9'	0'	QUICKRETE

7	CONTRACTOR'S OF LANDOWNER'S CERTIFICATION: This water well was plugged under my jurisdiction and was completed on (mo/day/year) SEPTEMBER 9, 2005 and this record is true to the best of my knowledge and belief. Kansas Water Well Contractor's License No. 699 This Water Well Record was completed on (mo/day/year) 9/09/05 under the business name of FLINT HILLS WINDMILL AND PUMP SERVICE by (signature) <i>[Signature]</i>	
---	--	--

INSTRUCTIONS: Use typewriter or ball point pen. Please press firmly and print clearly. Please fill in blanks, underline or circle the correct answers. Send top three copies to Kansas Department of Health and Environment, Bureau of Water, Geology Section, 1000 SW Jackson St., Ste. 420, Topeka, Kansas 66612-1367. Telephone: 785/296-5522. Send one to Water Well Owner and retain one for your records.