

USE TYPEWRITER OR BALL
POINT PEN-PRESS FIRMLY,
PRINT CLEARLY.

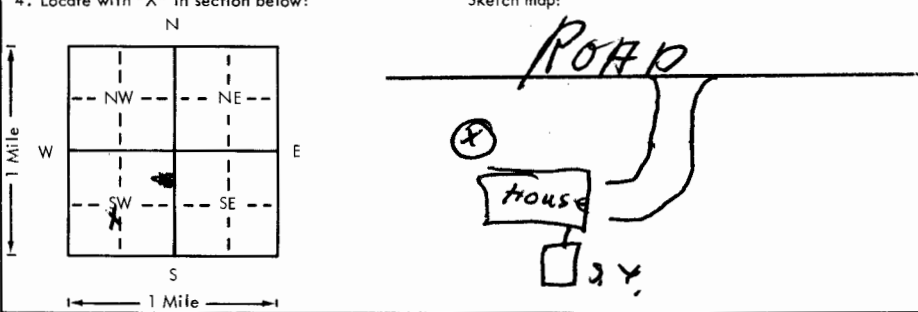
Well #7

Lot 17 Blk A

WATER WELL RECORD
KSA 82a-1201-1215

Kansas Department of Health and
Environment-Division of Environment
(Water well Contractors)
Topeka, Kansas 66620

Hillwood addition to Butler County

1. Location of well: County <u>Butler</u> Fraction <u>NE 1/4 SW 1/4 SW 1/4</u> Section number <u>33</u> Township number <u>T 28 S</u> Range number <u>R 3 E/W</u>	
2. Distance and direction from nearest town or city: <u>1 1/2 E. of Rose</u> 3. Owner of well: <u>Hayden Development</u> Street address of well location if in city: <u>Hill 1/2 No.</u> R.R. or street: <u>100 E. Silkmitter</u> City, state, zip code: <u>Rose Hill, KS 67133</u>	
4. Locate with "X" in section below: Sketch map: 	
5. Type and color of material	
6. Bore hole dia. <u>10 3/8</u> in. Completion date <u>6-14</u> Well depth <u>86</u> ft.	
7. Cable tool ☒ Rotary ☐ Driven ☐ Dug ☐ Hollow rod ☐ Jetted ☐ Bored ☐ Reverse rotary	
8. Use: ☒ Domestic ☐ Public supply ☐ Industry ☐ Irrigation ☐ Air conditioning ☐ Stock ☐ Lawn ☐ Oil field water ☐ Other	
9. Casing: Material <u>PVC</u> Height: Above or below Threaded ☐ Welded ☐ Surface <u>14</u> in. RMP <u>PVC</u> <u>BT</u> Weight <u>14</u> lbs./ft. Dia. <u>5</u> in. to <u>76</u> ft. depth Wall Thickness: inches or Dia. <u>5</u> in. to <u>76</u> ft. depth Gauge No. <u>258</u>	
10. Screen: Manufacturer's name <u>M.P.I.</u> Type <u>PVC</u> Dia. <u>5</u> Sig./gauze <u>25/100</u> Length <u>10</u> Set between <u>76</u> ft. and <u>86</u> ft. Gravel pack? <u>yes</u> Size range of material <u>7/16</u>	
11. Static water level: <u>30</u> ft. below land surface Date <u>6-14</u>	
12. Pumping level below land surfaces: <u>30</u> ft. after <u>20</u> hrs. pumping <u>20</u> g.p.m. <u>30</u> ft. after <u>20</u> hrs. pumping <u>20</u> g.p.m. Estimated maximum yield <u>20</u> g.p.m.	
13. Water sample submitted: <u>Yes</u> ☒ No ☐ Date <u>6-14</u>	
14. Well head completion: <u>C.P.P.</u> <u>14</u> Pitless adapter <u>14</u> inches above grade	
15. Well grouted? <u>yes</u> With: ☒ Neat cement ☐ Bentonite ☐ Concrete Depth: From <u>24</u> ft. to <u>13</u> ft.	
16. Nearest source of possible contamination: ft. <u>70</u> Direction <u>so</u> Type <u>s.t.</u> Well disinfected upon completion? ☒ Yes ☐ No	
17. Pump: ☒ Not installed Manufacturer's name _____ Model number _____ HP _____ Volts _____ Length of drop pipe _____ ft. capacity _____ g.p.m. Type: _____ ☐ Submersible ☐ Turbine ☐ Jet ☐ Reciprocating ☐ Centrifugal ☐ Other	
(Use a second sheet if needed)	
18. Elevation: Topography: _____ ☐ Hill ☐ Slope ☒ Upland ☐ Valley	19. Remarks: <u>well #7</u> <u>Owner well installed</u> <u>concrete slab. 4' x 4' x 4"</u> <u>Don E. Hayden</u>
20. Water well contractor's certification: This well was drilled under my jurisdiction and this report is true to the best of my knowledge and belief. <u>Phewst Const.</u> <u>353</u> Business name <u>Box 744</u> License No. _____ Address <u>Chick Creek</u> Signed <u>Don E. Hayden</u> Date <u>6-14-78</u> Authorized representative	

Forward the white, blue and pink copies to the Department of Health and Environment

Form WWC-5