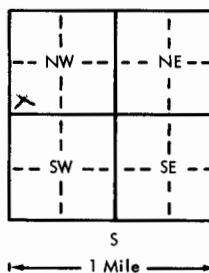
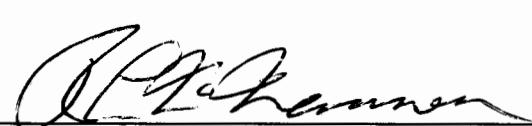


USE TYPEWRITER OR BALL
POINT PEN-PRESS FIRMLY,
PRINT CLEARLY.

WATER WELL RECORD
KSA 82a-1201-1215

Kansas Department of Health and
Environment-Division of Environment
(Water well Contractors)
Topeka, Kansas 66620

1. Location of well:	County Butler	Fraction SW 1/4 SW 1/4 NW 1/4	Section number 1	Township number T 28 S R 3	Range number EW
2. Distance and direction from nearest town or city:	4 W. 1 1/2 S		3. Owner of well: Ray Mcemann		
Street address of well location if in city:	of Augusta		R.R. or street: R# 3	City, state, zip code: Augusta Kansas 67010	
4. Locate with "X" in section below:			Sketch map: x well open field	6. Bore hole dia. 10 in. Completion date 1-23-76 Well depth 100 ft.	
5. Type and color of material	From	To	7. <input checked="" type="checkbox"/> Cable tool <input type="checkbox"/> Rotary <input type="checkbox"/> Driven <input type="checkbox"/> Dug <input type="checkbox"/> Hollow rod <input type="checkbox"/> Jetted <input type="checkbox"/> Bored <input type="checkbox"/> Reverse rotary		
Red Clay	0	10	8. Use: <input checked="" type="checkbox"/> Domestic <input type="checkbox"/> Public supply <input type="checkbox"/> Industry <input type="checkbox"/> Irrigation <input type="checkbox"/> Air conditioning <input type="checkbox"/> Stock <input type="checkbox"/> Lawn <input type="checkbox"/> Oil field water <input type="checkbox"/> Other		
Brown Clay	10	35	9. Casing: Material steel Height: Above 0 below 12 Threaded <input type="checkbox"/> Welded gl Surface 12 in. RMP X PVC Weight 175 lbs./ft. Dia. 6 in. to 100 ft. depth Wall Thickness: inches or Dia. 6 in. to ft. depth gage No. 175		
Blue shale	35	55	10. Screen: Manufacturer's name Oklahoma city Type RMP Dia. 6 in Slot/gauge 20 ft Length 20 ft Set between 80 ft. and 100 ft ft. and ft. Gravel pack 40 Size range of material 10		
Red Clay	55	75	11. Static water level: 37 ft. below land surface Date 1-23-76 mo./day/yr.		
Grey lime	75	85	12. Pumping level below land surfaces: ft. after hrs. pumping g.p.m. ft. after hrs. pumping g.p.m. Estimated maximum yield 15 g.p.m.		
Water	85		13. Water sample submitted: Yes <input checked="" type="checkbox"/> No Date mo./day/yr.		
Grey lime	85	100	14. Well head completion: Pitless adapter 12 Inches above grade		
			15. Well grouted? Yes With: <input checked="" type="checkbox"/> Neat cement <input type="checkbox"/> Bentonite <input type="checkbox"/> Concrete Depth: From 0 ft. to 12 ft.		
			16. Nearest source of possible contamination: ft. Direction Type Field Well disinfected upon completion? <input checked="" type="checkbox"/> Yes <input type="checkbox"/> No		
			17. Pump: <input checked="" type="checkbox"/> Not installed Manufacturer's name Wike Well Drilling Model number 122 HP 1 Volts 115 Length of drop pipe ft. capacity g.p.m. Type: <input type="checkbox"/> Submersible <input type="checkbox"/> Turbine <input type="checkbox"/> Jet <input type="checkbox"/> Reciprocating <input type="checkbox"/> Centrifugal <input type="checkbox"/> Other		
(Use a second sheet if needed)			18. Elevation: Topography: <input type="checkbox"/> Hill <input type="checkbox"/> Slope <input checked="" type="checkbox"/> Upland <input type="checkbox"/> Valley		
19. Remarks: Owner will put on slab. 			20. Water well contractor's certification: This well was drilled under my jurisdiction and this report is true to the best of my knowledge and belief. Business name Wike Well Drilling License No. 122 Address Augusta Kansas Signed Ray Mcemann Date 1-23-76 Authorized representative Ray Mcemann Date 1-23-76		