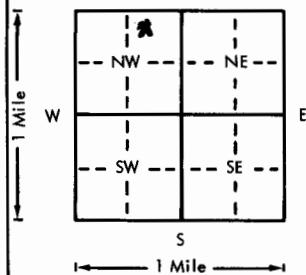


USE TYPEWRITER OR BALL
POINT PEN-PRESS FIRMLY,
PRINT CLEARLY.

WATER WELL RECORD
KSA 82a-1201-1215

Kansas Department of Health and
Environment-Division of Environment
(Water well Contractors)
Topeka, Kansas 66620

1. Location of well:	County <i>Butler</i>	Fraction 1/4	1/4 NW 1/4	Section number 2	T 28 S R 3 C	Range number	
2. Distance and direction from nearest town or city:	3W 25 2 $\frac{1}{2}$ W	3. Owner of well: R.R. or street: City, state, zip code:	<i>Edward Doleman 4600 Laura Wichita 77400</i>				
4. Locate with "X" in section below:	Sketch map: 		Sketch map: <i>x Well in grassland</i>				
5. Type and color of material	From	To	6. Bore hole dia. 10 in. Completion date 3-15-1977 Well depth 90 ft.				
	<i>Red Clay</i>	0	2	7. <input checked="" type="checkbox"/> Cable tool <input type="checkbox"/> Rotary <input type="checkbox"/> Driven <input type="checkbox"/> Dug <input type="checkbox"/> Hollow rod <input type="checkbox"/> Jetted <input type="checkbox"/> Bored <input type="checkbox"/> Reverse rotary			
	<i>Red Clay</i>	2	6	8. Use: <input checked="" type="checkbox"/> Domestic <input type="checkbox"/> Public supply <input type="checkbox"/> Industry <input type="checkbox"/> Irrigation <input type="checkbox"/> Air conditioning <input type="checkbox"/> Stock <input type="checkbox"/> Lawn <input type="checkbox"/> Oil field water <input type="checkbox"/> Other			
	<i>yellow shale</i>	6	24	9. Casing: Material <input checked="" type="checkbox"/> pitless Height: Above or below Threaded <input type="checkbox"/> Welded <input checked="" type="checkbox"/> 6 in. Surface 12 in. RMP <input checked="" type="checkbox"/> PVC <input type="checkbox"/> Weight lbs./ft. Dia. 6 in. to 90 ft. depth Wall Thickness: inches or Dia. <input type="checkbox"/> in. to <input type="checkbox"/> ft. depth gage No. -175			
	<i>Blue shale</i>	24	36	10. Screen: Manufacturer's name <i>g + L</i> Type <i>RMP</i> Dia. <i>6 in</i> <i>Screen/gauze</i> <i>1/16</i> Length <i>20 ft</i> Set between <i>90</i> ft. and <i>90</i> ft. ft. and <i>90</i> ft. Gravel pack? <i>no</i> Size range of material <i>1/2</i>			
	<i>grey shale</i>	32	72	11. Static water level: <i>47</i> ft. below land surface Date <i>3-15-1977</i>			
	<i>grey lime</i>	72	78	12. Pumping level below land surfaces: ft. after <input type="checkbox"/> hrs. pumping <input type="checkbox"/> g.p.m. ft. after <input type="checkbox"/> hrs. pumping <input type="checkbox"/> g.p.m. Estimated maximum yield <i>20</i> g.p.m.			
	<i>Water</i>	78		13. Water sample submitted: Yes <input checked="" type="checkbox"/> No Date			
	<i>grey lime</i>	78	90	14. Well head completion: <input checked="" type="checkbox"/> Pitless adapter <i>12</i> inches above grade			
				15. Well grouted? <i>yes</i> With: <input checked="" type="checkbox"/> Neat cement <input type="checkbox"/> Bentonite <input type="checkbox"/> Concrete Depth: From <i>3</i> ft. to <i>13</i> ft.			
				16. Nearest source of possible contamination: ft. <input type="checkbox"/> Direction <input type="checkbox"/> Type <i>Grassland</i> Well disinfected upon completion? <input checked="" type="checkbox"/> Yes <input type="checkbox"/> No			
				17. Pump: Not installed Manufacturer's name <i>Haynes</i> Model number <i>10 E 1 HP</i> Volts <i>220</i> Length of drop pipe <i>80</i> ft. capacity <i>10</i> g.p.m. Type: <input checked="" type="checkbox"/> Submersible <input type="checkbox"/> Turbine <input type="checkbox"/> Jet <input type="checkbox"/> Reciprocating <input type="checkbox"/> Centrifugal <input type="checkbox"/> Other			
18. Elevation:	(Use a second sheet if needed)		20. Water well contractor's certification: This well was drilled under my jurisdiction and this report is true to the best of my knowledge and belief. <i>Wike Well Drilling 122</i> Business name <i>Wike Well Drilling</i> License No. <i>122</i> Address <i>10 # 3 Box 1284 Augusta</i> Signed <i>Ed Doleman</i> Authorized representative <i>Ed Doleman</i> Date <i>3-15-1977</i>				
Topography: <input type="checkbox"/> Hill <input type="checkbox"/> Slope <input checked="" type="checkbox"/> Upland <input type="checkbox"/> Valley	19. Remarks: <i>owner will put on slab</i>						