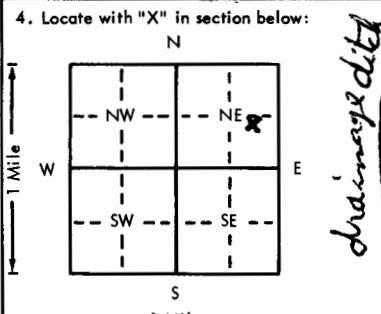


USE TYPEWRITER OR BALL
POINT PEN-PRESS FIRMLY,
PRINT CLEARLY.

WATER WELL RECORD
KSA 82a-1201-1215

Kansas Department of Health and
Environment-Division of Environment
(Water well Contractors)
Topeka, Kansas 66620

1. Location of well:	County <i>Butler</i>	Fraction 1/4 1/4 <i>NE 1/4</i>	Section number <i>2</i>	Township number <i>T 28</i>	Range number <i>S R 3 (EW)</i>
2. Distance and direction from nearest town or city:	<i>3W, 2S, 1N 1/2 S</i>		3. Owner of well: R.R. or street: City, state, zip code:	<i>Gordon Qualls 2339 S. Ridgewood Wichita Kans</i>	
4. Locate with "X" in section below:			Sketch map: <i>x well</i>	6. Bore hole dia. <i>10</i> in. Completion date Well depth <i>70</i> ft. <i>3-19-1977</i>	
5. Type and color of material	From	To	7. <input checked="" type="checkbox"/> Cable tool <input type="checkbox"/> Rotary <input type="checkbox"/> Driven <input type="checkbox"/> Dug <input type="checkbox"/> Hollow rod <input type="checkbox"/> Jetted <input type="checkbox"/> Bored <input type="checkbox"/> Reverse rotary		
	<i>0</i>	<i>9</i>	8. Use: <input checked="" type="checkbox"/> Domestic <input type="checkbox"/> Public supply <input type="checkbox"/> Industry <input type="checkbox"/> Irrigation <input type="checkbox"/> Air conditioning <input type="checkbox"/> Stock <input type="checkbox"/> Lawn <input type="checkbox"/> Oil field water <input type="checkbox"/> Other		
	<i>9</i>	<i>18</i>	9. Casing: Material <i>RMP</i> Height <i>Above</i> or below Threaded <input type="checkbox"/> Welded <i>90</i> Surface <i>12</i> in. RMP <input checked="" type="checkbox"/> PVC <input type="checkbox"/> Weight <i>12</i> lbs./ft. Dia. <i>6</i> in. to <i>70</i> ft. depth Wall Thickness: inches or Dia. <i>6</i> in. to <i>70</i> ft. depth gage No. <i>175</i>		
	<i>18</i>	<i>34</i>	10. Screen: Manufacturer's name <i>RMP</i> Type <i>RMP</i> Dia. <i>6</i> in. Slot/gauge. <i>1/16</i> Length <i>20</i> ft. Set between <i>50</i> ft. and <i>70</i> ft. ft. and <i>70</i> ft. Gravel pack? <i>no</i> Size range of material _____		
	<i>34</i>	<i>43</i>	11. Static water level: <i>20</i> ft. below land surface Date <i>3-19-1977</i>		
	<i>43</i>	<i>47</i>	12. Pumping level below land surfaces: ft. after hrs. pumping g.p.m. ft. after hrs. pumping g.p.m. Estimated maximum yield <i>30</i> g.p.m.		
	<i>47</i>	<i>53</i>	13. Water sample submitted: Yes <input checked="" type="checkbox"/> No Date _____		
	<i>53</i>	<i>62</i>	14. Well head completion: Pitless adapter <i>12</i> Inches above grade		
	<i>62</i>	<i>70</i>	15. Well grouted? <i>yes</i> With: <input checked="" type="checkbox"/> Neat cement <input type="checkbox"/> Bentonite <input type="checkbox"/> Concrete Depth: From <i>3</i> ft. to <i>13</i> ft.		
	<i>70</i>		16. Nearest source of possible contamination: ft. <i>300</i> Direction <i>West</i> Type <i>water</i> Well disinfected upon completion? <input checked="" type="checkbox"/> Yes <input type="checkbox"/> No		
			17. Pump: <input checked="" type="checkbox"/> Not installed Manufacturer's name _____ Model number _____ HP _____ Volts _____ Length of drop pipe _____ ft. capacity _____ g.p.m. Type: <input type="checkbox"/> Submersible <input type="checkbox"/> Turbine <input type="checkbox"/> Jet <input type="checkbox"/> Reciprocating <input type="checkbox"/> Centrifugal <input type="checkbox"/> Other		
18. Elevation:	(Use a second sheet if needed)		18. Water well contractor's certification: This well was drilled under my jurisdiction and this report is true to the best of my knowledge and belief. <i>Mike Well Drilling 122</i> Business name <i>Mike Well Drilling 122</i> License No. _____ Address <i>1413 Box 128 Augusta</i> Signed <i>Gordon Qualls</i> Authorized representative <i>3-19-1977</i>		
Topography:	<input type="checkbox"/> Hill <input checked="" type="checkbox"/> Slope <input checked="" type="checkbox"/> Upland <input type="checkbox"/> Valley				