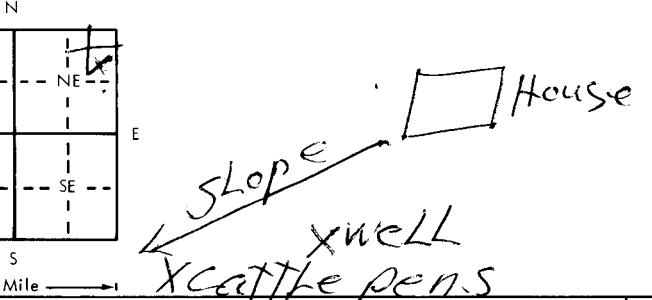


USE TYPEWRITER OR BALL
POINT PEN-PRESS FIRMLY,
PRINT CLEARLY.

WATER WELL RECORD
KSA 82a-1201-1215

Kansas Department of Health and
Environment-Division of Environment
(Water well Contractors)
Topeka, Kansas 66620

1. Location of well:	County Batler	Fraction SE 1/4 / E 1/4 / NE 1/4	Section number 4	Township number T 28	Range number S 3
2. Distance and direction from nearest town or city:	6N 2E		3. Owner of well: F.H. Land	Completion date 5/20/79	
Street address of well location if in city:	Rose Hill		R.R. or street: 16205	City, state, zip code: East Pawnee Wichita KAN 67230	
4. Locate with "X" in section below:	Sketch map:		6. Bore hole dia. 8 in. Well depth 100 ft.		
		Completion date 5/20/79			
5. Type and color of material	From	To	7. <input checked="" type="checkbox"/> Cable tool <input type="checkbox"/> Rotary <input type="checkbox"/> Driven <input type="checkbox"/> Dug <input type="checkbox"/> Hollow rod <input type="checkbox"/> Jetted <input type="checkbox"/> Bored <input type="checkbox"/> Reverse rotary		
Soil	0	5	8. Use: <input checked="" type="checkbox"/> Domestic <input type="checkbox"/> Public supply <input type="checkbox"/> Industry <input checked="" type="checkbox"/> Irrigation <input type="checkbox"/> Air conditioning <input type="checkbox"/> Stock <input type="checkbox"/> Lawn <input type="checkbox"/> Oil field water <input type="checkbox"/> Other		
Clay	5	10	9. Casing: Material DIS Height: Above or below Threaded <input type="checkbox"/> Welded <input checked="" type="checkbox"/> Surface 18 in. RMP 100 PVC Weight 100 lbs./ft. Dia. 5 in. to 100 ft. depth Wall Thickness: inches or Dia. 5 in. to 100 ft. depth gage No. 175		
Rock	10	25	10. Screen: Manufacturer's name SCC Flower		
Clay	25	45	Type 100 Dia. 5 Slot/gauge 1/16 Length 30 Set between 60 ft. and 80 ft. Gravel pack? None Size range of material _____		
Slate	45	60	11. Static water level: 50 ft. below land surface Date 5/20/79		
Water	60	75	12. Pumping level below land surfaces: 60 ft. after 1 hrs. pumping g.p.m. ft. after 1 hrs. pumping g.p.m. Estimated maximum yield 20 g.p.m.		
Lime	75	100	13. Water sample submitted: Yes <input checked="" type="checkbox"/> No Date _____		
Slate	100		14. Well head completion: Pitless adapter Inches above grade		
			15. Well grouted? Yes <input checked="" type="checkbox"/> With: <input type="checkbox"/> Neat cement <input type="checkbox"/> Bentonite <input checked="" type="checkbox"/> Concrete Depth: From 0 ft. to 10 ft.		
			16. Nearest source of possible contamination: 50 ft. SW pens ft. 50 Direction SW Type pens Well disinfected upon completion? Yes <input checked="" type="checkbox"/> No _____		
			17. Pump: Not installed Manufacturer's name _____ Model number _____ HP _____ Volts _____ Length of drop pipe _____ ft. capacity _____ g.p.m. Type: <input type="checkbox"/> Submersible <input type="checkbox"/> Turbine <input type="checkbox"/> Jet <input type="checkbox"/> Reciprocating <input type="checkbox"/> Centrifugal <input type="checkbox"/> Other		
(Use a second sheet if needed)			20. Water well contractor's certification: This well was drilled under my jurisdiction and this report is true to the best of my knowledge and belief. Winter Well Drilling Business name R. Winter License No. 25 Address R 24885 1/4 mi N Signed Charles Winter Date 3/14/80 Authorized representative _____		
18. Elevation:	19. Remarks:				
Topography: <input type="checkbox"/> Hill <input type="checkbox"/> Slope <input checked="" type="checkbox"/> Upland <input type="checkbox"/> Valley					

Forward the white, blue and pink copies to the Department of Health and Environment

Form WWC-5