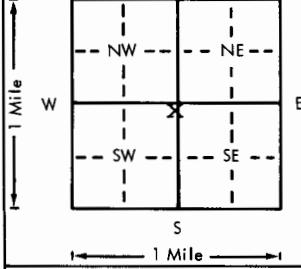


USE TYPEWRITER OR BALL
POINT PEN-PRESS FIRMLY,
PRINT CLEARLY.

WATER WELL RECORD
KSA 82a-1201-1215

Kansas Department of Health and
Environment-Division of Environment
(Water well Contractors)
Topeka, Kansas 66620

Location of well:	County	Fraction	Section number	Township number	Range number
	Butler	NE 1/4 SE 1/4 SW 1/4	5	T 28	S R 3E E/W
Distance and direction from nearest town or city: 1/2 East of Rose Hill Rd. on the 31st Street address of well location if in city: Street South, and then 1/2 mile North.		3. Owner of well: David Blanton R.R. or street: 9175 East Douglas City, state, zip code: Wichita, Kansas			
4. Locate with "X" in section below: 		Sketch map: Rose Hill. Kansas			
		6. Bore hole dia. 11 in. Completion date 6-6-77 Well depth 95 ft.			
		7. <input checked="" type="checkbox"/> Cable tool <input checked="" type="checkbox"/> Rotary <input type="checkbox"/> Driven <input type="checkbox"/> Dug <input type="checkbox"/> Hollow rod <input checked="" type="checkbox"/> Jetted <input type="checkbox"/> Bored <input type="checkbox"/> Reverse rotary			
		8. Use: <input checked="" type="checkbox"/> Domestic <input type="checkbox"/> Public supply <input type="checkbox"/> Industry <input type="checkbox"/> Irrigation <input type="checkbox"/> Air conditioning <input type="checkbox"/> Stock <input type="checkbox"/> Lawn <input type="checkbox"/> Oil field water <input type="checkbox"/> Other			
		9. Casing: Material Styrene Height: Above or below Threaded <input type="checkbox"/> Welded 8 1/2 Surface 12 in. RMP X PVC <input type="checkbox"/> Weight <input type="checkbox"/> lbs./ft. Dia. 5 in. to 95 ft. depth Wall Thickness: inches or Dia. <input type="checkbox"/> in. to <input type="checkbox"/> ft. depth Gauge No. 200			
		10. Screen: Manufacturer's name Sunflower Plastic Type Styrene Dia. 5" Slot/gauge .06 Length 75' Set between 20 ft. and 95 ft. ft. and 95 ft. Gravel pack yes Size range of material 1-1/8"			
		11. Static water level: 18 ft. below land surface Date 6-6-77 18 ft. below land surface Date 6-6-77			
		12. Pumping level below land surfaces: ft. after <input type="checkbox"/> hrs. pumping <input type="checkbox"/> g.p.m. ft. after <input type="checkbox"/> hrs. pumping <input type="checkbox"/> g.p.m. Estimated maximum yield <input type="checkbox"/> g.p.m.			
		13. Water sample submitted: <input type="checkbox"/> mo./day/yr. Yes <input type="checkbox"/> No <input type="checkbox"/> Date <input type="checkbox"/>			
		14. Well head completion: X Pitless adapter 12 Inches above grade			
		15. Well grouted? yes 1 to 2 fine sand mix. With: <input type="checkbox"/> Neat cement <input type="checkbox"/> Bentonite <input checked="" type="checkbox"/> Concrete Depth: From 40" ft. to 14 ft.			
		16. Nearest source of possible contamination: ft. 75 Direction East Type Septic Tank Well disinfected upon completion? X Yes <input type="checkbox"/> No			
		17. Pump: Manufacturer's name Sta-Rite Not installed Model number 20P4D02HP 3/4 Volts 230 Length of drop pipe 90 ft. capacity 20 g.p.m. Type: X Submersible <input type="checkbox"/> Turbine <input type="checkbox"/> Jet <input type="checkbox"/> Reciprocating <input type="checkbox"/> Centrifugal <input type="checkbox"/> Other			
18. Elevation: Topography: <input type="checkbox"/> Hill X Slope <input type="checkbox"/> Upland <input type="checkbox"/> Valley		19. Remarks: (Use a second sheet if needed)			
		20. Water well contractor's certification: This well was drilled under my jurisdiction and this report is true to the best of my knowledge and belief. Harp Well & Pump 236 Business name Wichita, Kansas License No. Address Wichita, Kansas Signed M. Arnold Date 7-27-77 Authorized representative M. Arnold Date 7-27-77			