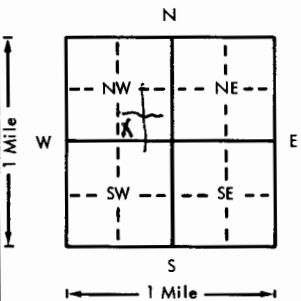


USE TYPEWRITER OR BALL
POINT PEN-PRESS FIRMLY,
PRINT CLEARLY.

WATER WELL RECORD
KSA 82a-1201-1215

Kansas Department of Health and
Environment-Division of Environment
(Water well Contractors)
Topeka, Kansas 66620

1. Location of well:		County BUTLER	Fraction SW 1/4 SE 1/4 NW 1/4	Section number 10	Township number T 28 S	Range number R 3E	E/W
2. Distance and direction from nearest town or city: 3.56 2E 1/2 SO of ANDOVER				3. Owner of well: BAXTER R.R. or street: GARY City, state, zip code: AUGUSTA KS			
4. Locate with "X" in section below:		Sketch map:		6. Bore hole dia. 8 in. Completion date 5-18-76 Well depth 116 ft.			
				7. ☒ Cable tool ☐ Rotary ☐ Driven ☐ Dug ☐ Hollow rod ☐ Jetted ☐ Bored ☐ Reverse rotary			
5. Type and color of material		From		To		8. Use: ☒ Domestic ☐ Public supply ☐ Industry ☐ Irrigation ☐ Air conditioning ☐ Stock ☐ Lawn ☐ Oil field water ☐ Other	
Brown Gumao Surface		0		6		9. Casing: Material ☐ Height: Above or below Threaded ☐ Welded ☐ Surface 12 in. RMP ☒ PVC ☐ Weight ☐ lbs./ft.	
Yellow Clay		7		27		Dia. 6 in. to 96 ft. depth Wall Thickness: inches or Dia. ☐ in. to ☐ ft. depth gage No. TYPE 100	
Gray Limestone		28		85		10. Screen: Manufacturer's name Simmons Type RMP Dia. 6" Slot/gauze ☐ Length 20 ft Set between 96 ft. and 116 ft. Gravel pack? ☒ Size range of material 3/4" to 1"	
Light Gray Water Shale		86		87		11. Static water level: ☐ mo./day/yr. 60 ft. below land surface Date 5-18-76	
Gray Limestone		88		110		12. Pumping level below land surfaces: ☐ ft. after ☐ hrs. pumping ☐ g.p.m. ☐ ft. after ☐ hrs. pumping ☐ g.p.m. Estimated maximum yield 20 g.p.m.	
Gray Water Shale		111		113		13. Water sample submitted: ☐ mo./day/yr. Yes ☒ No ☐ Date ☐	
Gray Limestone		114		116		14. Well head completion: ☐ Pitless adapter 12 inches above grade	
						15. Well grouted? ☒ With: ☒ Neat cement ☐ Bentonite ☐ Concrete Depth: From 0 ft. to 12 ft.	
						16. Nearest source of possible contamination: ft. 200 Direction NE Type Septic Well disinfected upon completion? ☒ Yes ☐ No	
						17. Pump: ☒ Not installed Manufacturer's name ☐ Model number ☐ HP ☐ Volts ☐ Length of drop pipe ☐ ft. capacity ☐ g.p.m. Type: ☐ Submersible ☐ Turbine ☐ Jet ☐ Reciprocating ☐ Centrifugal ☐ Other	
						20. Water well contractor's certification: This well was drilled under my jurisdiction and this report is true to the best of my knowledge and belief. SIMMONS DRILLING 162 Business name 156 CENT ANDOVER License No. 1/4 Address 156 CENT ANDOVER Signed Barry Date 5/18/76 Authorized representative	
18. Elevation:		19. Remarks:					
Topography: ☒ Hill ☐ Slope ☐ Upland ☐ Valley							

Forward the white, blue and pink copies to the Department of Health and Environment

Form WWC-5