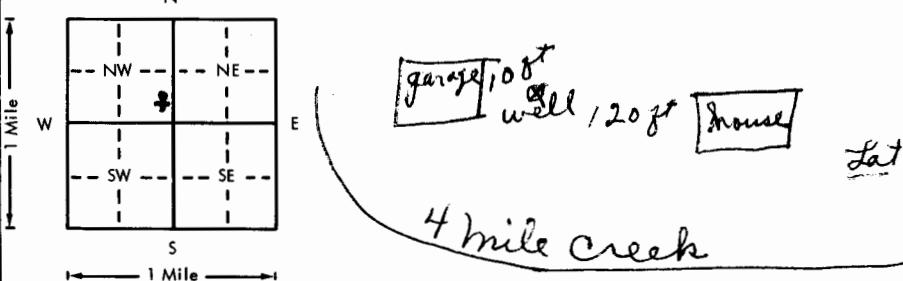


USE TYPEWRITER OR BALL
POINT PEN-PRESS FIRMLY,
PRINT CLEARLY.

WATER WELL RECORD
KSA 82a-1201-1215

Kansas Department of Health and
Environment-Division of Environment
(Water well Contractors)
Topeka, Kansas 66620

1. Location of well:	County Butter	Fraction NE 1/4 SE 1/4 NW 1/4	Section number 12	Township number T 28	Range number S R 3
2. Distance and direction from nearest town or city: 3 W. 3 S. 3/4 W. 1/4 S Street address of well location if in city: 2 Augusta		3. Owner of well: Harold Clee Ralston R.R. or street: Route 3 City, state, zip code: Augusta Kans 67010			
4. Locate with "X" in section below: 		6. Bore hole dia. 10 in. Completion date 1-29-76 Well depth 40 ft.			
5. Type and color of material		7. ☒ Cable tool ☐ Rotary ☐ Driven ☐ Dug ☐ Hollow rod ☐ Jetted ☐ Bored ☐ Reverse rotary			
		8. Use: ☒ Domestic ☐ Public supply ☐ Industry ☐ Irrigation ☐ Air conditioning ☐ Stock ☐ Lawn ☐ Oil field water ☐ Other			
		9. Casing: Material plastic Height above or below Threaded ☐ Welded ☒ Surface 4 ft RMP ☒ PVC ☐ Weight 4 lbs./ft. Dia. 6 in. to 40 ft. depth Wall Thickness: inches or Dia. 1/2 in. to 40 ft. depth gage No. 175			
		10. Screen: Manufacturer's name Shelbourn City Type RMP Dia. 6 Slot gauge 30/40 Length 10 ft Set between 30 ft. and 40 ft. Gravel pack? no Size range of material			
		11. Static water level: 10 ft. below land surface Date 1-29-76 mo./day/yr.			
		12. Pumping level below land surfaces: ____ ft. after ____ hrs. pumping ____ g.p.m. ____ ft. after ____ hrs. pumping ____ g.p.m. Estimated maximum yield 20 g.p.m.			
		13. Water sample submitted: ____ mo./day/yr. Yes ☒ No ☐ Date			
		14. Well head completion: 4 ft inches above grade ____ Pitless adapter			
		15. Well grouted? ☒ With: ☒ Neat cement ☐ Bentonite ☐ Concrete Depth: From 0 ft. to 10 ft.			
		16. Nearest source of possible contamination: ft. ____ Direction South Type River Well disinfected upon completion? ☒ Yes ☐ No			
		17. Pump: Not installed Manufacturer's name Houlds Model number 10E-1 HP 1/2 Volts 230 Length of drop pipe 35 ft. capacity 10 g.p.m. Type: ☒ Submersible ☐ Turbine ☐ Jet ☐ Reciprocating ☐ Centrifugal ☐ Other			
18. Elevation:		19. Remarks: 35 ft 8" steel casing was set in and cemented bottom to top. River water was shut off. 6 inch plastic casing was set inside and cemented between the two at 30 ft and 10 ft to 0 feet			
Topography: ☐ Hill ☐ Slope ☐ Upland ☒ Valley		20. Water well contractor's certification: This well was drilled under my jurisdiction and this report is true to the best of my knowledge and belief. Wike Well drilling 122 Business name Augusta Kans License No. 122 Address Augusta Kans Signed W. Wike Date 1-29-76 Authorized representative			

Forward the white, blue and pink copies to the Department of Health and Environment

Form WWC-5