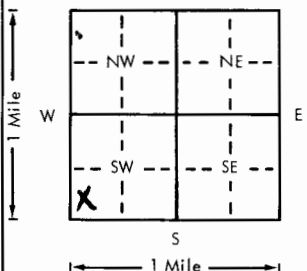


USE TYPEWRITER OR BALL
POINT PEN-PRESS FIRMLY,
PRINT CLEARLY.

WATER WELL RECORD
KSA 82a-1201-1215

Kansas Department of Health and
Environment-Division of Environment
(Water well Contractors)
Topeka, Kansas 66620

1. Location of well:		County Butler	Fraction SW 1/4 SW 1/4	Section number 16	Township number T 28 S	Range number R 3E	E/W
2. Distance and direction from nearest town or city: 1 mile East of Rose Hill Road and 1/4 mile North of 47th on the east side of the road.				3. Owner of well: Jack McKown R.R. or street: RR #1 Box 182 City, state, zip code: Augusta, Kansas			
4. Locate with "X" in section below:		Sketch map: Augusta, Kansas		6. Bore hole dia. 11 in. Completion date 10-6-78 Well depth 65 ft.			
				7. ☒ Cable tool ☒ Rotary ☐ Driven ☐ Dug ☐ Hollow rod ☐ Jetted ☐ Bored ☐ Reverse rotary			
5. Type and color of material		From		To		8. Use: ☒ Domestic ☐ Public supply ☐ Industry ☐ Irrigation ☐ Air conditioning ☐ Stock ☐ Lawn ☐ Oil field water ☐ Other	
Topsoil		0		2		9. Casing: Material Styrene Height: Above or below below Threaded ☐ Welded ☒ Surface 12 in. RMP ☒ PVC ☐ Weight 12 lbs./ft. Dia. 5 in. to 65 ft. depth Wall Thickness: inches or 1/2 Dia. 5 in. to 65 ft. depth gage No. 200	
Clay		2		21		10. ☒ Screen Manufacturer's name Sunflower plastic Type styrene Dia. 5" Slot 1/16 in. .06 Length 30' Set between 35 ft. and 65 ft. ft. and 1/4-1/8" ft. Gravel pack? yes Size range of material 1/4-1/8"	
Grey shale soft		21		52		11. Static water level: 37 ft. below land surface Date 10-6-78 mo./day/yr.	
Blue shale		52		65		12. Pumping level below land surfaces: ft. after 37 hrs. pumping 37 g.p.m. ft. after 37 hrs. pumping 37 g.p.m. Estimated maximum yield 37 g.p.m.	
						13. Water sample submitted: Yes ☐ No ☐ Date 10-6-78 mo./day/yr.	
						14. Well head completion: ☒ Pitless adapter 12 inches above grade	
						15. Well grouted? yes 1-2 fine sand mix With: ☐ Neat cement ☐ Bentonite ☒ Concrete Depth: From 40" ft. to 14 ft.	
						16. Nearest source of possible contamination: ft. 85 Direction South Type Septic Well disinfected upon completion? ☒ Yes ☐ No ☐ tank	
						17. Pump: ☐ Not installed Manufacturer's name Jacuzzi Model number 7S4C HP 3/4 Volts 230 Length of drop pipe 50 ft. capacity 20 g.p.m. Type: ☒ Submersible ☐ Turbine ☐ Jet ☐ Reciprocating ☐ Centrifugal ☐ Other	
						(Use a second sheet if needed)	
18. Elevation:		19. Remarks:		20. Water well contractor's certification: This well was drilled under my jurisdiction and this report is true to the best of my knowledge and belief. Harp Well & Pump 236 Business name License No. Address Wichita, Kansas 67209 Signed M. Arnold Date 12-4-78 Authorized representative			
Topography: ☐ Hill ☐ Slope ☐ Upland ☐ Valley		Flat ground					

Forward the white, blue and pink copies to the Department of Health and Environment

Form WWC-5