

1 LOCATION OF WATER WELL:		Fraction	Section Number	Township Number	Range Number
County:	BUTLER	NW ¼ SE ¼ SE ¼	18	T 28 S	R 3 E <u>EW</u>

Distance and direction from nearest town or city street address of well if located within city?

3125 Cowslip Rose Hill, KS. approx. 47th So. & Rose Hill Road, $\frac{1}{2}$ N, $\frac{1}{2}$ W.


2] WATER WELL OWNER: Wayne Wright Construction
RR#, St. Address, Box # : 4937 Bison
City, State, ZIP Code : Wichita, Kansas

Board of Agriculture, Division of Water Resources
Application Number:

3 LOCATE WELL'S LOCATION WITH AN "X" IN SECTION BOX: 4 DEPTH OF COMPLETED WELL... 100 ft. ELEVATION: 25

Depth(s) Groundwater Encountered 1. 35 ft. 2. ft. 3. ft.

WELL'S STATIC WATER LEVEL 35 ft. below land surface measured on mo/day/yr 6-7-88

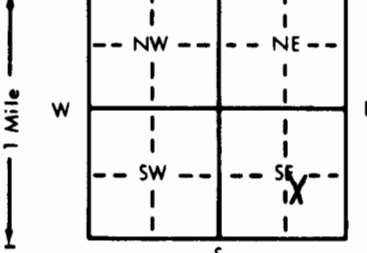



Pump test data: Well water was ft. after hours pumping gpm

Est. Yield gpm: Well water was ft. after hours pumping gpm

Bore Hole Diameter . . . 11 . . . in. to . . . ft., and . . . in. to . . . ft.

WELL WATER TO BE USED AS: 5. Public water supply 8. Air conditioning 11. Injection well

1 Domestic	3 Feedlot	6 Oil field water supply	9 Dewatering	12 Other (Specify below)
------------	-----------	--------------------------	--------------	--------------------------

2 Irrigation 4 Industrial 7 Lawn and garden only 10 Monitoring well

Was a chemical/bacteriological sample submitted to Department? Yes.....No. XX...; If yes, mo/day/yr sample was submitted

5	TYPE OF BLANK CASING USED:	5 Wrought iron	8 Concrete tile	CASING JOINTS: Glued . . XX . Clamped
---	----------------------------	----------------	-----------------	---

1 Steel 3 RMP (SR) 6 Asbestos-Cement 9 Other (specify below) Welded

	2 PVC	4 ABS	7 Fiberglass	Cer-Mac styrene SDR-26	Threaded
Blank casing diameter	5	in. to	40	ft. Dia	in. to

Casing height above land surface 12 . . . in. weight 1.59 . . . lbs./ft. Wall thickness or gauge No. 203 . . .

TYPE OF SCREEN OR PERFORATION MATERIAL: 7 PVC 10 Asbestos-cement

1 Steel	3 Stainless steel	5 Fiberglass	8 RMP (SR)	11 Other (specify)
2 Brass	4 Carbonized steel	6 Concrete/tile	9 ABS	12 None used (open hole)

2 Brass 4 Galvanized steel 6 Concrete tile 9 ABS 12 None used (open hole)

SCREEN OR PERFORATION OPENINGS ARE: 5 Gauzed wrapped 8 Saw cut 11 None (open hole)

1 Continuous slot	3 Mill slot	6 Wire wrapped	9 Drilled holes
-------------------	-------------	----------------	-----------------

2 Louvered shutter	4 Key punched	7 Torch cut	10 Other (specify)
SCREEN PERFORATED INTERNALS	5	100	

SCREEN-PERFORATED INTERVALS: From ft. to ft., From ft. to ft.
From ft. to ft. From ft. to ft.

GRAVEL PACK INTERVALS: From 24 ft. to 100 ft., From _____ ft. to _____ ft.

	From	ft. to	ft., From	ft. to	ft.
1. FRONT MATERIAL					

8) GROUT MATERIAL: 1 Neat cement 2 Cement grout 3 Bentonite 4 Other

Grout Intervals: From 4 ft to 24 ft From ft to ft From ft to ft

What is the nearest source of possible contamination: 10 Livestock pens 14 Abandoned water well

1 Septic tank	4 Lateral lines	7 Pit privy	11 Fuel storage	15 Oil well/Gas well
---------------	-----------------	-------------	-----------------	----------------------

2 Sewer lines	5 Cess pool	8 Sewage lagoon	12 Fertilizer storage	16 Other (specify below)
3 Watertight sewer lines	6 Seepage pit	9 Feedyard	13 Insecticide storage	

3 Waterlight sewer lines	6 Seepage pit	9 Feedyard	10 Insecticide storage	62'
Direction from well?		North	How many feet?	

FROM	TO	LITHOLOGIC LOG	FROM	TO	PLUGGING INTERVALS
0	0	Formation			

0	3	Topsoil			
3	9	Clay			

9	45	Brown Shale			
---	----	-------------	--	--	--

45	100	Gray Shale			
----	-----	------------	--	--	--


--	--	--	--	--	--

7 CONTRACTOR'S OR LANDOWNER'S CERTIFICATION: This water well was (1) constructed, (2) reconstructed, or (3) plugged under my jurisdiction and was

completed on (mo/day/year) 6-7-88 and this record is true to the best of my knowledge and belief. Kansas
 15-30-89

Water Well Contractor's License No. 236 This Water Well Record was completed on (mo/day/yr) 10/28/2010
under the business name of Harp Well & Pump Service, Inc. by (signature) Mary Arnold

INSTRUCTIONS: Use typewriter or ball point pen. PLEASE PRESS FIRMLY and PRINT clearly. Please fill in blanks, underline or circle the correct answers. Send to three copies to Kansas Department

of Health and Environment, Bureau of Water Protection, Topeka, Kansas 66620-7320. Telephone: 913-296-5514. Send one to WATER WELL OWNER and retain one for your records.