

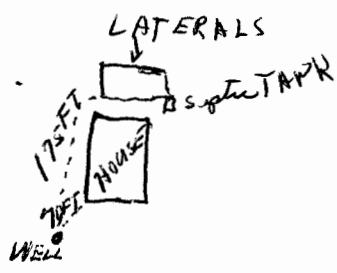
USE TYPEWRITER OR BALL
POINT PEN-PRESS FIRMLY,
PRINT CLEARLY.

WATER WELL RECORD
KSA 82a-1201-1215

T R EW sec 1/4 1/4 1/4 No.

Kansas State Dept. Of Health
(Water Well Contractors)
Forbes-Bldg. 740
Topeka, Kansas 66620

NW 1/4

1 Location of well:	County BUTLER	Township name Pleasant	Fraction NW 1/4	Section number 19	Town number 285	Range number 3E
Distance and direction from nearest town or city: 3 NORTH 1 WEST ROSEHILL KS Street address of well location if in city: 47 ST 50 + 159 ST EAST				3 Owner of well: BOB WALLER Address: ROSE HILL KS		
Locate with "X" in section below: N W E S 1 Mile		Sketch map: 		4 Well depth: 81 ft. Date of completion 6-2-75 Well diameter 8 in.		
				5 ☒ Cable tool ☐ Rotary ☐ Driven ☐ Dug ☐ Hollow rod ☐ Jetted ☐ Bored ☐ Reverse rotary		
				6 Use: ☒ Domestic ☐ Public supply ☐ Industry ☐ Irrigation ☐ Air conditioning ☐ Commercial ☐ Test well ☐		
				7 Casing: Material PLS Height: above/below Threaded ☐ Welded ☐ Surface 12 in. Diam. 6 in. to 6 ft. depth Drive shoe? ☐ Yes ☐ No _____ in. to _____ ft. depth		
				8 Screen: SUNFLOWER Manufacturer _____ Type 100 RMP Dia. 6" ☒ Slot gauge PRILLED Length 20 FT Set between 61 ft. and 81 ft. Fittings: _____ Gravel pack ☒ Yes ☐ No Size range of material 3/4 PERMILL		
2 Type and color of material		From To		9 Static water level: 14 ft. below land surface Date 6-2-75		
				10 Pumping level below land surfaces: _____ ft. after _____ hrs. pumping _____ g.p.m. _____ ft. after _____ hrs. pumping _____ g.p.m. Estimated maximum yield 40 g.p.m.		
				11 Water sample submitted: ☐ Yes ☒ No Date _____		
				12 Well head completion: 12" ABOVE ☒ Pitless adapter ☐ Inches above grade		
				13 Well grouted? ☒ Yes ☐ No ☒ Neat cement ☐ Bentonite ☐ _____ Depth: From 3 ft. to 18 ft.		
				14 Nearest source of possible contamination: LATERALS ft. 175 Direction NORTH Type _____ Well disinfected upon completion? ☒ Yes ☐ No		
				15 Pump: ☐ Not installed Manufacturer's name F+W Model number WBK9 HP 1 Volts 230 Length of drop pipe 70 ft. capacity 19 g.p.m. Type: ☒ Submersible ☐ Turbine ☐ Jet ☐ Reciprocating ☐ Centrifugal ☐ Other		
				16 Remarks: elevation Customer to run 4x4 concrete slab when they pour driveway		
				17 Water well contractor's certification: This well was drilled under my jurisdiction and this report is true to the best of my knowledge and belief. SIMMONS DRILLING Business name _____ License No. _____ Address 115 E CENTRAL AVE ANDOVER Signed Don Simmons Date 6-2-75 Authorized representative		