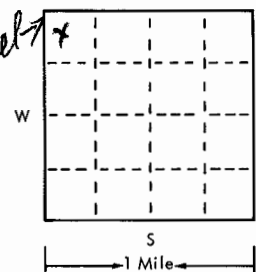
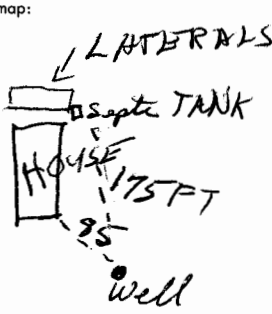


USE TYPEWRITER OR BALL
POINT PEN-PRESS FIRMLY,
PRINT CLEARLY.

WATER WELL RECORD
KSA 82a-1201-1215

T R EW sec 1/4 1/4 1/4 No.

Kansas State Dept. Of Health
(Water Well Contractors)
Forbes-Bldg. 740
Topeka, Kansas 66620

1 Location of well:	County BUTLER	Township name PLEASANT	Fraction NW 1/4	Section number 19	Town number 28S	Range number 3E	
Distance and direction from nearest town or city: 3 NORTH 1 West ROSE HILLS KS			3 Owner of well: BOB WALKER Address: ROSE HILLS KS RRI Box 115A				
Street address of well location if in city: 4754 50th 159 ST EAST							
Locate with "X" in section below: 			Sketch map: 			4 Well depth: 53 ft. Date of completion 9-28-75 Well diameter 8 in.	
2 Type and color of material			From		To		
			BROWN BUMBO		0	4	
			FAN CLAY		4	10	
			Yellow Clay		10	25	
			Gray Clay		25	44	
Soft Limestone Rock		44	46				
Gray Water Shale		46	48				
Dark Gray Clay		48	53				
					8 Screen: Manufacturer SUNFLOWER Type 100 RMP Dia. 6" Slot gauge DRILLED Length 20 FT Set between 33 ft. and 53 ft. Fittings: Gravel pack ☒ Yes ☐ No Size range of material 3/8		
					9 Static water level: 20 ft. below land surface Date 9-28-75		
					10 Pumping level below land surfaces: ____ ft. after ____ hrs. pumping ____ g.p.m. ____ ft. after ____ hrs. pumping ____ g.p.m. Estimated maximum yield 8 g.p.m.		
					11 Water sample submitted: ☐ Yes ☒ No Date ____		
					12 Well head completion: ☒ Pitless adapter ☐ Inches above grade		
					13 Well grouted? ☐ Yes ☐ No ☒ Neat cement ☐ Bentonite ☐ _____ Depth: From 26 ft. to 20 ft.		
					14 Nearest source of possible contamination: ft. 175 Direction NORTH Type Septic Tank Well disinfected upon completion? ☒ Yes ☐ No		
					15 Pump: ☒ Not installed Manufacturer's name _____ Model number _____ HP _____ Volts _____ Length of drop pipe _____ ft. capacity _____ g.m.p. Type: ☐ Submersible ☐ Turbine ☐ Jet ☐ Reciprocating ☐ Centrifugal ☐ Other		
16 Remarks: elevation			17 Water well contractor's certification: This well was drilled under my jurisdiction and this report is true to the best of my knowledge and belief. SIMMONS DRILLING Business name _____ License No. _____ Address 115 E CENTRAL AVE Signed Bob Walker Date 9-28-75 Authorized representative				

Forward the white, blue and pink copies to the Kansas State Dept. Of Health.

Form WWC-5