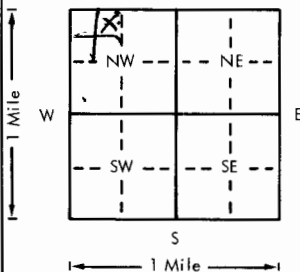
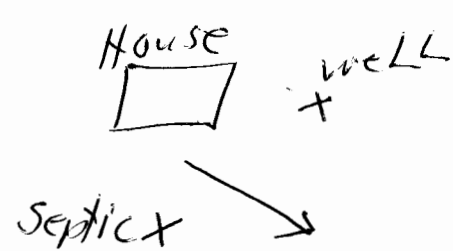


USE TYPEWRITER OR BALL
POINT PEN-PRESS FIRMLY,
PRINT CLEARLY.

WATER WELL RECORD
KSA 82a-1201-1215

Kansas Department of Health and
Environment-Division of Environment
(Water well Contractors)
Topeka, Kansas 66620

1. Location of well:		County Butler	Fraction NE 1/4 NW 1/4 NW 1/4	Section number 19	Township number T 28 S	Range number R 3 E
2. Distance and direction from nearest town or city: 2 1/2 mi W			3. Owner of well: Chuck Jordan			
Street address of well location if in city: Rose Hill			R.R. or street: 2730 Thistle Lane			
			City, state, zip code: Rose 67133			
4. Locate with "X" in section below:		Sketch map:		6. Bore hole dia. 8 in. Completion date 3/17/80		
				Well depth 100 ft.		
5. Type and color of material		From	To	7. ☒ Cable tool ☐ Rotary ☐ Driven ☐ Dug		
soil		0	4	☐ Hollow rod ☐ Jetted ☐ Bored ☐ Reverse rotary		
Clay		4	20	8. Use: ☒ Domestic ☐ Public supply ☐ Industry		
Clay yellow		20	35	☐ Irrigation ☐ Air conditioning ☐ Stock		
Shale		35	50	☐ Lawn ☐ Oil field water ☐ Other		
water Rock clay yellow		50	60	9. Casing: Material PS Height: Above or below		
Lime & shale		60	75	Threaded ☐ Welded ☒ Surface 18 in.		
Lime		75	85	RMP ☒ PVC ☐ Weight 100 lbs./ft.		
Shale		85	100	Dia. 5 in. to 100 ft. depth Wall Thickness: inches or		
				Dia. 5 in. to 100 ft. depth gage No. 175		
				10. Screen: Manufacturer's name Sunflower		
				Type 100 Dia. 5		
				Slot/gauze 1/16 Length 20		
				Set between 1/60 ft. and 80 ft.		
				Gravel pack? yes Size range of material 3/8 - 1/2		
				11. Static water level: 20 ft. below land surface Date 3/18/80		
				12. Pumping level below land surfaces: 25 ft. after 1 hrs. pumping Bailing		
				Estimated maximum yield 30 g.p.m.		
				13. Water sample submitted: 30 g.p.m.		
				14. Well head completion: Yes Pitless adapter Yes Inches above grade		
				15. Well grouted? Yes With: Neat cement Bentonite Concrete		
				Depth: From 3 ft. to 13 ft.		
				16. Nearest source of possible contamination: 150 ft. Direction SE Type Septic		
				Well disinfected upon completion? Yes		
				17. Pump: Not installed		
				☐ Submersible ☐ Turbine		
				☐ Jet ☐ Reciprocating		
				☐ Centrifugal ☐ Other		
18. Elevation:		19. Remarks:		20. Water well contractor's certification:		
Topography: ☐ Hill ☐ Slope ☒ Upland ☐ Valley				This well was drilled under my jurisdiction and this report is true to the best of my knowledge and belief.		
				Business name Winter Well Drill		
				Address Box 30 Augusta		
				Signed Charles Lenta License No. 1/4		
				Authorized representative Date 3/18/80		

Forward the white, blue and pink copies to the Department of Health and Environment

Form WWC-5