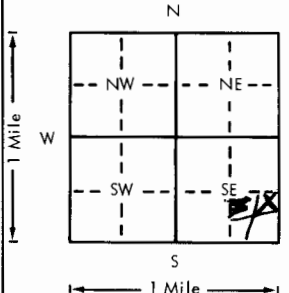
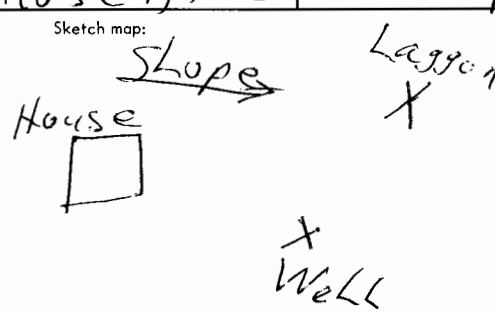


USE TYPEWRITER OR BALL
POINT PEN-PRESS FIRMLY,
PRINT CLEARLY.

WATER WELL RECORD
KSA 82a-1201-1215

Kansas Department of Health and
Environment-Division of Environment
(Water well Contractors)
Topeka, Kansas 66620

1. Location of well:		County Butler	Fraction NE 1/4 SE 1/4 SE 1/4	Section number 20	Township number T 28 S	Range number R 3 E
2. Distance and direction from nearest town or city:		2 N 2 E		3. Owner of well: Bob Westall		
Street address of well location if in city:		OF Rose Hill		R.R. or street: 2105 Howalter		
				City, state, zip code: Rose Hill 67133		
4. Locate with "X" in section below:		Sketch map:		6. Bore hole dia. 8 in. Completion date 3/19/80		
				Well depth 85 ft.		
5. Type and color of material		From		To		7. ☒ Cable tool ☐ Rotary ☐ Driven ☐ Dug
						☐ Hollow rod ☐ Jetted ☐ Bored ☐ Reverse rotary
						8. Use: ☒ Domestic ☐ Public supply ☐ Industry
						☐ Irrigation ☐ Air conditioning ☐ Stock
						☐ Lawn ☐ Oil field water ☐ Other
						9. Casing: Material 5 Height: Above or below
						Threaded ☐ Welded 9L Surface 18 in.
						RMP ☒ PVC ☐ Weight 100 lbs./ft.
						Dia. 5 in. to 85 ft. depth Wall Thickness: inches or
						Dia. ☐ in. to ☐ ft. depth gage No. 175
						10. Screen: Manufacturer's name Sun Flower
						Type 100 Dia. 5
						Slot/gauze 1/16 Length 20
						Set between 60 ft. and 80 ft.
						Gravel pack? None Size range of material
						11. Static water level: 30 ft. below land surface Date 3/10/80
						12. Pumping level below land surfaces: Bailing
						35 ft. after 1 hrs. pumping ☐ g.p.m.
						☐ ft. after ☐ hrs. pumping ☐ g.p.m.
						Estimated maximum yield 30 g.p.m.
						13. Water sample submitted: ☐ Yes ☐ No Date
						14. Well head completion: ☐ Pitless adapter ☐ Inches above grade
						15. Well grouted? yes
						With: ☐ Neat cement ☐ Bentonite ☒ Concrete
						Depth: From 0 ft. to 10 ft.
						16. Nearest source of possible contamination: septic
						ft. 150 Direction NE Type septic
						Well disinfected upon completion? ☒ Yes ☐ No
						17. Pump: ☒ Not installed
						Manufacturer's name
						Model number ☐ HP ☐ Volts
						Length of drop pipe ☐ ft. capacity ☐ g.p.m.
						Type:
						☐ Submersible ☐ Turbine
						☐ Jet ☐ Reciprocating
						☐ Centrifugal ☐ Other
18. Elevation:		19. Remarks:		20. Water well contractor's certification:		
Topography:				This well was drilled under my jurisdiction and this report is true to the best of my knowledge and belief.		
☐ Hill				Business name Winter Well Drilling		
☐ Slope				Address Box 30 Augusta		
☒ Upland				Signed Charles Winter Date 3/26/80		
☐ Valley				Authorized representative		

Forward the white, blue and pink copies to the Department of Health and Environment

Form WWC-5