USE TYPEWRITER OR BALL POINT PEN-PRESS FIRMLY, PRINT CLEARLY.

WATER WELL RECORD
KSA 82a-1201-1215

Kansas Department of Health and Environment-Division of Environment
(Water well Contractors)
Topeka, Kansas 66620

1. Location of well:	County	Fraction	Section number	Township number	Range number
	BUTLER	NW 1/4 NW 1/4 SE 1/4	22	T 28 S	R 3 E/W

2. Distance and direction from nearest town or city: 3 mile SOUTH OF 54 HIWAY + 1 mile EAST OF SANTA FE
Street address of well location if in city: LAKE ROAD ON EAST SIDE

3. Owner of well: JAMES OWSLEY
R.R. or street: 17000 MAPLE
City, state, zip code: GODDARD, KANSAS

4. Locate with "X" in section below: Sketch map: ANDOVER, KANSAS

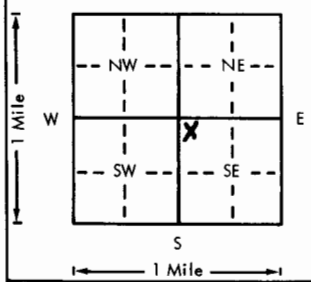

6. Bore hole dia. 11 in. Completion date 1-6-77
Well depth 90 ft.

7. __ Cable tool ✓ Rotary __ Driven __ Dug
__ Hollow rod __ Jetted __ Bored __ Reverse rotary

8. Use: ✓ Domestic __ Public supply __ Industry
__ Irrigation __ Air conditioning __ Stock
__ Lawn __ Oil field water __ Other

9. Casing: Material STYRENE GL Height: Above or below
Threaded __ Welded __ Surface 12 in.
RMP ✓ PVC __ Weight __ lbs./ft.
Dia. 5 in. to 90 ft. depth Wall Thickness: inches or
Dia. __ in. to __ ft. depth gage No. 1200

5. Type and color of material	From	To
TOPSOIL	0	2
CLAY	2	19
SHALE (BLUE) HARD	19	63
LIMESTONE - (GRAY) HARD	63	90

10. Screen: Manufacturer's name SUNFLOWER PLASTIC
Type STYRENE Dia. 5"
Slot/gauze 106 Length 70'
Set between 20 ft. and 90 ft.
ft. and ft.
Gravel pack? YES Size range of material 1/4 - 1/8"

11. Static water level: mo./day/yr.
21 ft. below land surface Date 1-6-77

12. Pumping level below land surfaces:
ft. after hrs. pumping g.p.m.
ft. after hrs. pumping g.p.m.
Estimated maximum yield g.p.m.

13. Water sample submitted: mo./day/yr.
__ Yes __ No Date

14. Well head completion: CAPPED
__ Pitless adapter 12 Inches above grade

15. Well grouted? YES
With: __ Neat cement __ Bentonite ✓ Concrete
Depth: From 40' to 14 ft.

16. Nearest source of possible contamination: SEPTIC
ft. 70 Direction EAST Type TANK
Well disinfected upon completion? ✓ Yes __ No

17. Pump: ✓ Not installed
Manufacturer's name
Model number HP Volts
Length of drop pipe ft. capacity g.p.m.
Type:
__ Submersible __ Turbine
__ Jet __ Reciprocating
__ Centrifugal __ Other

(Use a second sheet if needed)

18. Elevation:

Topography:
__ Hill
✓ Slope
__ Upland
__ Valley

19. Remarks:

20. Water well contractor's certification:
This well was drilled under my jurisdiction and this report is true to the best of my knowledge and belief.
HARP WELL + PUMP 236
Business name License No.
Address WICHITA, KANSAS
Signed M. Arnold Date 1-21-77
Authorized representative

28 T - 3 R E/W - 22 Sec - NW 1/4 NW 1/4 SE 1/4

Forward the white, blue and pink copies to the Department of Health and Environment

Form WWC-5

MI-1023