USE TYPEWRITER OR BALL POINT PEN-PRESS FIRMLY, PRINT CLEARLY.

WATER WELL RECORD
KSA 82a-1201-1215

Kansas Department of Health and Environment-Division of Environment
(Water well Contractors)
Topeka, Kansas 66620

1. Location of well:	County	Fraction	Section number	Township number	Range number
	Butler	NW 1/4 SW/4 SW/4	23	T 28 S	R 3E E/W

2. Distance and direction from nearest town or city: #2 North
Street address of well location if in city: 4 miles East to the Rose Hill Rd

3. Owner of well: Bob Miller
R.R. or street: R#1 Box 118
City, state, zip code: Douglas, Kansas

4. Locate with "X" in section below:

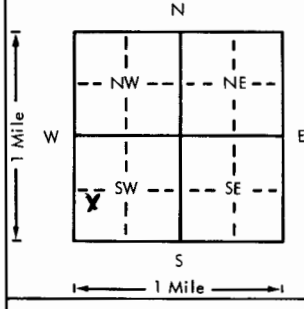

Sketch map: and 1/2 mile North
Rose Hill Kansas

6. Bore hole dia. 11 in. Completion date 3-1-77
Well depth 123 ft.

7. ___ Cable tool ✓ Rotary ___ Driven ___ Dug
___ Hollow rod ___ Jetted ___ Bored ___ Reverse rotary

8. Use: ✓ Domestic ___ Public supply ___ Industry
___ Irrigation ___ Air conditioning ___ Stock
___ Lawn ___ Oil field water ___ Other

9. Casing: Material Styrene Height (Above or below)
Threaded ___ Welded ___ Surface 12 in.
RMP ✓ PVC ___ Weight ___ lbs./ft.
Dia. 5 in. to 123 ft. depth Wall Thickness: inches or
Dia. ___ in. to ___ ft. depth gage No. 200

5. Type and color of material	From	To
Topsoil	0	3
Brown Clay	3	15
Brown Shale	15	30
Gray Shale	30	60
Brown Shale	60	85
Gray Shale	85	110
Brown Hard Shale	110	123
~~Red Shale~~		
(Use a second sheet if needed)		

10. Screen: Manufacturer's name Sunflower Plastics
Type Styrene Dia. 5"
Slot/~~gauze~~ .06 Length 40 ft
Set between 83 ft. and 123 ft.
___ ft. and ___ ft.
Gravel pack? Yes Size range of material 1/4-1 1/8"

11. Static water level: mo./day/yr.
83 ft. below land surface Date 3-1-77

12. Pumping level below land surfaces:
___ ft. after ___ hrs. pumping ___ g.p.m.
___ ft. after ___ hrs. pumping ___ g.p.m.
Estimated maximum yield ___ g.p.m.

13. Water sample submitted: mo./day/yr.
___ Yes ___ No Date ___

14. Well head completion: Capped
___ Pitless adapter 12 Inches above grade

15. Well grouted? Yes
With: ___ Neat cement ___ Bentonite ✓ Concrete
Depth: From 40 ft. to 14 ft. OK

16. Nearest source of possible contamination: None
ft. ___ Direction ___ Type ___
Well disinfected upon completion? ✓ Yes ___ No

17. Pump: ✓ Not installed
Manufacturer's name ___
Model number ___ HP ___ Volts ___
Length of drop pipe ___ ft. capacity ___ g.p.m.
Type:
___ Submersible ___ Turbine
___ Jet ___ Reciprocating
___ Centrifugal ___ Other

T 28 R 3 E/W Sec 23 NW 1/4 SW 1/4 SW 1/4

18. Elevation:

Topography:
___ Hill
✓ Slope
___ Upland
___ Valley

19. Remarks:
Septic System not installed when the well was drilled.
No apparent source for Contamination.

20. Water well contractor's certification:
This well was drilled under my jurisdiction and this report is true to the best of my knowledge and belief.
Sharp Well-Pump 236
Business name License No.
Address Wichita, Kansas
Signed M. Arnold Date 3-22-77
Authorized representative

Forward the white, blue and pink copies to the Department of Health and Environment

Form WWC-5

MI-1023