USE TYPEWRITER OR BALL POINT PEN-PRESS FIRMLY, PRINT CLEARLY.

WATER WELL RECORD
KSA 82a-1201-1215

Kansas Department of Health and Environment-Division of Environment
(Water well Contractors)
Topeka, Kansas 66620

1. Location of well:	County: Butler	Fraction: SE 1/4 NW 1/4 NE 1/4	Section number: 24	Township number: T 28 S	Range number: R 3 (E) W

2. Distance and direction from nearest town or city: 3.W 5.S 1/4 W of Augusta Kans
Street address of well location if in city:

3. Owner of well: Lee A Hopp
R.R. or street: RR3 Box 225
City, state, zip code: Augusta Kan 67010

4. Locate with "X" in section below:

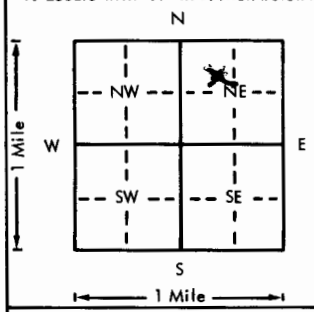

Sketch map: X Well in Pasture

6. Bore hole dia. 10 in. Completion date
Well depth 80 ft. 9-24-1976

7. X Cable tool __ Rotary __ Driven __ Dug
__ Hollow rod __ Jetted __ Bored __ Reverse rotary

8. Use: X Domestic __ Public supply __ Industry
__ Irrigation __ Air conditioning __ Stock
__ Lawn __ Oil field water __ Other

9. Casing: Material galv Height: Above or below
Threaded __ Welded gl Surface 18 in.
RMP X PVC __ Weight __ lbs./ft.
Dia. 6 in. to 80 ft. depth Wall Thickness: inches or
Dia. __ in. to __ ft. depth gage No. .175 MNC

10. Screen: Manufacturer's name GLE
Type RMP Dia. 6 in
Slot gauze 1/16 Length 20 ft
Set between 60 ft. and 80 ft.
ft. and ft.
Gravel pack? no Size range of material

11. Static water level: mo./day/yr.
36 ft. below land surface Date 9-24-1976

12. Pumping level below land surfaces:
ft. after hrs. pumping g.p.m.
ft. after hrs. pumping g.p.m.
Estimated maximum yield 11 g.p.m.

13. Water sample submitted: mo./day/yr.
__ Yes X No Date

14. Well head completion:
__ Pitless adapter 18 Inches above grade

15. Well grouted? yes
With: X Neat cement __ Bentonite __ Concrete
Depth: From 12 ft. to 0 ft.

16. Nearest source of possible contamination:
ft. Direction Type pasture MNC
Well disinfected upon completion? X Yes __ No

17. Pump: X Not installed
Manufacturer's name
Model number HP Volts
Length of drop pipe ft. capacity g.p.m.
Type:
__ Submersible __ Turbine
__ Jet __ Reciprocating
__ Centrifugal __ Other

5. Type and color of material

Type and color of material	From	To
Red Clay	0	7
grey shale	7	22
yellow shale	22	28
yellow lime	28	46
Blue shale	46	63
grey shale	63	66
Red shale	66	69
Water	69	
grey lime	69	80

(Use a second sheet if needed)

18. Elevation:
Topography:
__ Hill
__ Slope
X Upland
__ Valley

19. Remarks: owner will put on slab

Lee A Hopp

20. Water well contractor's certification:
This well was drilled under my jurisdiction and this report is true to the best of my knowledge and belief.
Business name Wike well drilling License No. 122
Address R#3 Box 128L Augusta Kan
Signed Murray Wike Date 9-24-1976
Authorized representative

28 — 3 (E) 24 SE NW NE
T R W Sec 1/4 1/4 1/4

Forward the white, blue and pink copies to the Department of Health and Environment

Form WWC-5

MI-1023