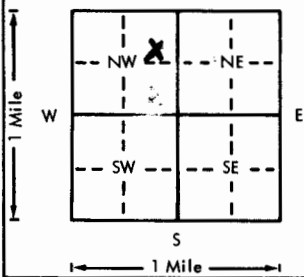


USE TYPEWRITER OR BALL
POINT PEN-PRESS FIRMLY,
PRINT CLEARLY.

WATER WELL RECORD
KSA 82a-1201-1215

Kansas Department of Health and
Environment-Division of Environment
(Water well Contractors)
Topeka, Kansas 66620

1. Location of well:		County Butler	Fraction CS 1/4 NE 1/4 NW 1/4	Section number 24	Township number T 28 S R 3 E	Range number 3
2. Distance and direction from nearest town or city: Street address of well location if in city:		3 W 5 S 1/2 W of Augusta Kans		3. Owner of well: R.R. or street: Route 3 City, state, zip code: Augusta Kansas 67010		
4. Locate with "X" in section below: N W E S 1 Mile		Sketch map: 		6. Bore hole dia. 10 in. Completion date Well depth 100 ft. 9-27-1976		
5. Type and color of material		From		To		7. ☒ Cable tool ☐ Rotary ☐ Driven ☐ Dug ☐ Hollow rod ☐ Jetted ☐ Bored ☐ Reverse rotary
Red Clay		0		9		8. Use: ☒ Domestic ☐ Public supply ☐ Industry ☐ Irrigation ☐ Air conditioning ☐ Stock ☐ Lawn ☐ Oil field water ☐ Other
Blue shale		9		18		9. Casing: Material plastic Height (Above or below Threaded ☐ Welded ☒ Surface 16 in. RMP ☒ PVC ☐ Weight ☐ lbs./ft. Dia. 6 in. to 100 ft. depth Wall Thickness: inches or Dia. ☐ in. to ☐ ft. depth gage No. 175
yellow lime		18		45		10. Screen: Manufacturer's name gt & L Type RMP Dia. 6 in Slot gauze 1/16 Length 20 Set between 80 ft. and 100 ft. ft. and ☐ ft. Gravel pack? no Size range of material ☐
Blue shale		45		56		11. Static water level: ☐ mo./day/yr. 55 ft. below land surface Date 9-27-1976
Red shale		56		81		12. Pumping level below land surfaces: ft. after ☐ hrs. pumping ☐ g.p.m. ft. after ☐ hrs. pumping ☐ g.p.m. Estimated maximum yield 20 g.p.m.
grey shale		81		90		13. Water sample submitted: ☐ mo./day/yr. Yes ☒ No Date ☐
water		90				14. Well head completion: Pitless adapter 16 Inches above grade
grey lime		90		100		15. Well grouted? yes With: ☒ Neat cement ☐ Bentonite ☐ Concrete Depth: From 3 ft. to 12 ft.
Water turned out bad so the well was plugged.						16. Nearest source of possible contamination: ft. 125 Direction South Type lagoon Well disinfected upon completion? ☒ Yes ☐ No
						17. Pump: ☒ Not installed Manufacturer's name ☐ Model number ☐ HP ☐ Volts ☐ Length of drop pipe ☐ ft. capacity ☐ g.p.m. Type: ☐ Submersible ☐ Turbine ☐ Jet ☐ Reciprocating ☐ Centrifugal ☐ Other
18. Elevation:		19. Remarks: owner will put on slab William L Brown		20. Water well contractor's certification: This well was drilled under my jurisdiction and this report is true to the best of my knowledge and belief. Wibe Well Drilling 122 Business name Wibe Well Drilling 122 License No. 1142 Address Box 1284 Augusta Signed Theray Wibe Date 9-27-1976 Authorized representative		

Forward the white, blue and pink copies to the Department of Health and Environment

Form WWC-5