USE TYPEWRITER OR BALL POINT PEN-PRESS FIRMLY, PRINT CLEARLY.

WATER WELL RECORD
KSA 82a-1201-1215

Kansas Department of Health and Environment-Division of Environment
(Water well Contractors)
Topeka, Kansas 66620

1. Location of well:	County	Fraction	Section number	Township number	Range number
	Butler	SW 1/4 NW 1/4 ~~NW~~ NE 1/4	24	T 28 S	R 3 E W

2. Distance and direction from nearest town or city: 3W. 55, 1/2 W
Street address of well location if in city: of Augusta Kans

3. Owner of well: Bill Brown
R.R. or street: Route 3
City, state, zip code: Augusta Kansas 67010

4. Locate with "X" in section below:

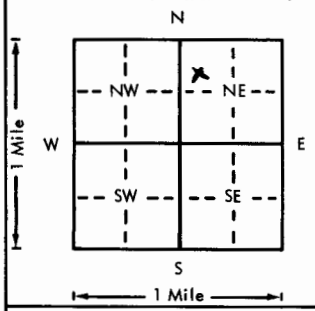

Sketch map:

6. Bore hole dia. 10 in. Completion date
Well depth 85 ft. 10-22-76

7. X Cable tool __ Rotary __ Driven __ Dug
__ Hollow rod __ Jetted __ Bored __ Reverse rotary

8. Use: X Domestic __ Public supply __ Industry
__ Irrigation __ Air conditioning __ Stock
__ Lawn __ Oil field water __ Other

9. Casing: Material plstc Height: (Above) or below
Threaded __ Welded gl Surface 16 in.
RMP X PVC __ Weight __ lbs./ft.
Dia. 6 in. to 85 ft. depth Wall Thickness: inches or
Dia. __ in. to __ ft. depth gage No. .175

5. Type and color of material	From	To
Red Clay	0	15
Blue Shale	15	20
yellow Shale	20	27
yellow lime	27	52
Water	52	
Blue shale	52	60
Red shale	60	81
Grey Shale	81	85

(Use a second sheet if needed)

10. Screen: Manufacturer's name gtx
Type RMP Dia. 6 in
(Slot) gauze 1/16 Length 20
Set between 50 ft. and 60 ft.
85 ft. and ft.
Gravel pack? No Size range of material

11. Static water level: mo./day/yr.
31 ft. below land surface Date 10-22-76

12. Pumping level below land surfaces:
ft. after hrs. pumping g.p.m.
ft. after hrs. pumping g.p.m.
Estimated maximum yield 7 g.p.m.

13. Water sample submitted: mo./day/yr.
__ Yes X No Date

14. Well head completion:
__ Pitless adapter 16 Inches above grade

15. Well grouted? yes
With: X Neat cement __ Bentonite __ Concrete
Depth: From 3 ft. to 12 ft.

16. Nearest source of possible contamination:
ft. 175 Direction South Type lagoon
Well disinfected upon completion? X Yes __ No

17. Pump: X Not installed
Manufacturer's name
Model number HP Volts
Length of drop pipe ft. capacity g.p.m.
Type:
__ Submersible __ Turbine
__ Jet __ Reciprocating
__ Centrifugal __ Other

18. Elevation:

Topography:
__ Hill
__ Slope
X Upland
__ Valley

19. Remarks:
owner will put on Slab

William S Brown

20. Water well contractor's certification:
This well was drilled under my jurisdiction and this report is true to the best of my knowledge and belief.
Wine well Drilling 122
Business name License No.
Address R# 3 Box 128L Augusta Kans
Signed Murray Wine Authorized representative Date 10-22-76

T 28 R 3 W Sec 24 SW 1/4 NW 1/4 NE 1/4

Forward the white, blue and pink copies to the Department of Health and Environment

Form WWC-5

MI-1023