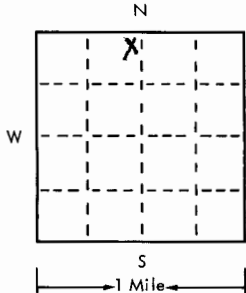
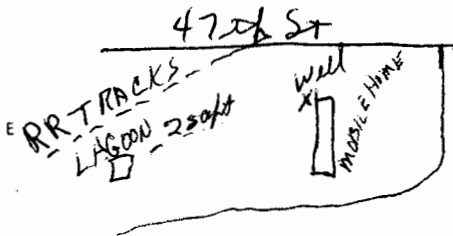


USE TYPEWRITER OR BALL
POINT PEN-PRESS FIRMLY,
PRINT CLEARLY.

WATER WELL RECORD
KSA 82a-1201-1215

T R EW sec 1/4 1/4 1/4 No.

Kansas State Dept. Of Health
(Water Well Contractors)
Forbes-Bldg. 740
Topeka, Kansas 66620

1 Location of well:	County BUTLER	Township name PLESANT	Fraction NE 1/4 NW 1/4	Section number 24	Town number 28S	Range number 2E		
Distance and direction from nearest town or city: 2 mi No 4 1/2 E of ROSE HILL KANSAS			3 Owner of well: MAX GILMORE Address: AUGUSTA KS					
Locate with "X" in section below: 			Sketch map: 			4 Well depth: 69 ft. Date of completion: 6-5-76 Well diameter: 8 in.		
2 Type and color of material			From			To		
			Brown Surface Clay			0 8		
			Yellow Clay			9 28		
			Light Limestone			29 31		
			Light Gray Clay			32 41		
Light Gray Water Shale			42 43					
Gray Clay			44 60					
Gray Water Shale			61 64					
Dark Gray Clay			65 69					
(use a second sheet if needed)								
16 Remarks: elevation			17 Water well contractor's certification:			18		
Topography: ☐ Hill ☐ Slope ☒ Upland ☐ Valley			This well was drilled under my jurisdiction and this report is true to the best of my knowledge and belief. Simmons Drilling 162 Business name License No. Address 155 CENT ANNAVE R Signed [Signature] Date 6-5-76 Authorized representative			3 E 24 NE NE NW		

Forward the white, blue and pink copies to the Kansas State Dept. Of Health.

Form WWC-5