USE TYPEWRITER OR BALL POINT PEN-PRESS FIRMLY, PRINT CLEARLY.

T R EW sec 1/4 1/4 1/4 No.

WATER WELL RECORD
KSA 82a-1201-1215

Kansas State Dept. Of Health
(Water Well Contractors)
Forbes-Bldg. 740
Topeka, Kansas 66620

1 Location of well:	County	Township name	Fraction	Section number	Town number	Range number
	Butler	Pleasant	S ½ NE ¼ SE SE NE	~~25~~ 26	T 28S	R 3E

Distance and direction from nearest town or city: 2½ north 4 east Rosehill Kans

Street address of well location if in city:

3 Owner of well: Edward S. Ferry

Address: 327 Ralston Rd Wichita Kans 67209

Locate with "X" in section below:

Sketch map:

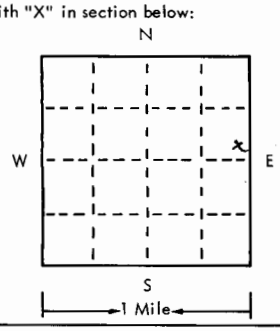

4 Well depth: 100 ft. Date of completion aug 16 197
Well diameter 7 in.

5 ☒ Cable tool ☐ Rotary ☐ Driven ☐ Dug
☐ Hollow rod ☐ Jetted ☐ Bored ☐ Reverse rotary

6 Use: ☒ Domestic ☐ Public supply ☐ Industry
☐ Irrigation ☐ Air conditioning ☐ Commercial
☐ Test well ☐

7 Casing: Material styrene Height: (above) below
Threaded ☐ Welded ☒ Surface 18 in.
Diam. Weight 1.5 lbs./ft.
10 in. to 10 ft. depth Drive shoe? ☐ Yes ☒ No
7 in. to 100 ft. depth

8 Screen: Sunflower plastic Inc Wichita Kan
Manufacturer
Type R.P. 145 Dia. 6"
(Slot) gauze 1/16 Length 20 ft
Set between 80 ft. and 100 ft.
Fittings:
Gravel pack ☐ Yes ☒ No Size range of material

9 Static water level:
60 ft. below land surface Date aug 16, 1975

10 Pumping level below land surfaces:
ft. after hrs. pumping g.p.m.
ft. after hrs. pumping g.p.m.
Estimated maximum yield 20+ g.p.m.

11 Water sample submitted:
☐ Yes ☒ No Date

12 Well head completion:
☐ Pitless adapter ☒ 18 Inches above grade

13 Well grouted? ☒ Yes ☐ No
☒ Neat cement ☐ Bentonite ☐
Depth: From 10 ft. to 0 ft.

14 Nearest source of possible contamination:
ft. ½ mile Direction north Type Septic
Well disinfected upon completion? ☒ Yes ☐ No

15 Pump: ☒ Not installed
Manufacturer's name
Model number HP Volts
Length of drop pipe ft. capacity g.m.p.
Type:
☐ Submersible ☐ Turbine
☐ Jet ☐ Reciprocating
☐ Certrifugal ☐ Other

2 Type and color of material	From	To
Red Clay	0	5
yellow lime	5	20
yellow Clay	20	40
Blue Shale	40	55
grey lime	55	75
yellow lime	75	90
water	90	
grey lime	90	100
owner will put on slab		

(use a second sheet if needed)

16 Remarks: elevation

Topography:
☒ Hill
☐ Slope
☐ Upland
☐ Valley

17 Water well contractor's certification:
This well was drilled under my jurisdiction and this report is true to the best of my knowledge and belief.
Murray Wike 122
Business name License No.
Address Augusta Ks.
Signed Murray Wike Date aug 16, 1975
Authorized representative

Forward the white, blue and pink copies to the Kansas State Dept. Of Health.

Form WWC-5

677-H