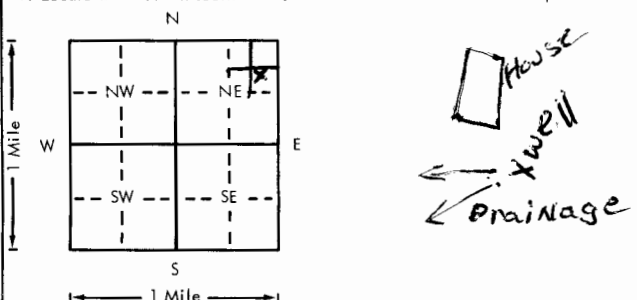


USE TYPEWRITER OR BALL
POINT PEN-PRESS FIRMLY,
PRINT CLEARLY.

WATER WELL RECORD
KSA 82a-1201-1215

Kansas Department of Health and
Environment-Division of Environment
(Water well Contractors)
Topeka, Kansas 66620

1. Location of well:	County Butler	Fraction SE 1/4 NE 1/4 NE 1/4	Section number 26	Township number T 28 S	Range number R 3 E
2. Distance and direction from nearest town or city: Street address of well location if in city:	IN 4E 3/4 N Rose Hill KS		3. Owner of well: STAN JOYES R.R. or street: R #1 Box 235A City, state, zip code: Rose Hill KS 67133		
4. Locate with "X" in section below:	Sketch map: 		6. Bore hole dia 8.5 in. Completion date 9-5-78 Well depth 73 ft.		
5. Type and color of material	From	To	7. ☒ Cable tool ☐ Rotary ☐ Driven ☐ Dug ☐ Hollow rod ☐ Jetted ☐ Bored ☐ Reverse rotary		
Top soil	0	1	8. Use: ☒ Domestic ☐ Public supply ☐ Industry ☐ Irrigation ☐ Air conditioning ☐ Stock ☐ Lawn ☐ Oil field water ☐ Other		
clay Brown	1	5	9. Casing: Material PITS Height: Above or below Threaded ☐ Welded glue Surface 24 in. RMP ☒ PVC ☐ Weight ☐ lbs./ft. Dia. 5 in. to 73 ft. depth Wall Thickness: inches or Dia. ☐ in. to ☐ ft. depth gage No. 200		
clay yellow	5	10	10. Screen: Manufacturer's name SUNFLOWER PITS P.P.E. INC. Type RMP Dia. 5" Slot/gauze 3/64 Length 10' Set between 63 ft. and 73 ft. ☐ ft. and ☐ ft.		
Limestone yellow	10	25	Gravel pack? ☒ Size range of material 24-34		
clay yellow	25	40	11. Static water level: ☐ mo./day/yr. 58 ft. below land surface Date 9-5-78		
Shale light gray	40	44	12. Pumping level below land surfaces: NA ☐ ft. after ☐ hrs. pumping ☐ g.p.m. ☐ ft. after ☐ hrs. pumping ☐ g.p.m. Estimated maximum yield ☐ g.p.m.		
Shale Blue gray	44	49	13. Water sample submitted: ☐ mo./day/yr. Yes ☒ No ☐ Date ☐		
Shale green	49	50	14. Well head completion: ☒ Pitless adapter 24 Inches above grade		
Limestone yellow gray	50	70	15. Well grouted? ☒ With: ☐ Neat cement ☐ Bentonite ☒ Concrete Depth: From 13 ft. to 5 ft.		
water 64 ft			16. Nearest source of possible contamination: NA ft. ☐ Direction ☐ Type ☐ Well disinfected upon completion? ☒ Yes ☐ No		
Limestone yellow	70	73	17. Pump: ☒ Not installed Manufacturer's name ☐ Model number ☐ HP ☐ Volts ☐ Length of drop pipe ☐ ft. capacity ☐ g.p.m. Type: ☐ Submersible ☐ Turbine ☐ Jet ☐ Reciprocating ☐ Centrifugal ☐ Other		
(Use a second sheet if needed)					
18. Elevation:	19. Remarks: owner will install concrete + slab		20. Water well contractor's certification: This well was drilled under my jurisdiction and this report is true to the best of my knowledge and belief. Brady Water Wells 363 Business name ☐ License No. ☐ Address Box 178 Douglas KS Signed Richard Brady date 9-6-78 Authorized representative		
Topography: ☐ Hill ☒ Slope ☐ Upland ☐ Valley					

Forward the white, blue and pink copies to the Department of Health and Environment

Form WWC-5