

LOCATION OF WATER WELL: County: Butler	Fraction NW 1/4 NW 1/4 NE 1/4	Section Number 27	Township Number T 28 S	Range Number R 3 E
--	---	-----------------------------	----------------------------------	------------------------------

Distance and direction from nearest town or city street address of well if located within city?

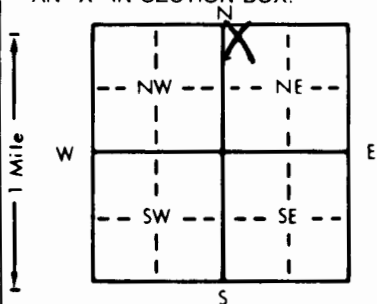
2 1/2 mi. East and 1/2 mi. North of Rose Hill

WATER WELL OWNER: **MARY NAGY**
 RR#, St. Address, Box #: **RR#1 Box 229B**
 City, State, ZIP Code: **Rose Hill, Ks. 67133**

Board of Agriculture, Division of Water Resources

Application Number:

3 LOCATE WELL'S LOCATION WITH AN "X" IN SECTION BOX:

4 DEPTH OF COMPLETED WELL: **127** ft. ELEVATION:Depth(s) Groundwater Encountered 1. **115** ft. 2. ft. 3. ft.WELL'S STATIC WATER LEVEL **40** ft. below land surface measured on mo/day/yr **3/4/92**

Pump test data: Well water was ft. after hours pumping gpm

Est. Yield **70** gpm: Well water was ft. after hours pumping gpmBore Hole Diameter **10** in. to ft., and in. to ft.

WELL WATER TO BE USED AS: 5 Public water supply 8 Air conditioning 11 Injection well

1 Domestic 3 Feedlot 6 Oil field water supply 9 Dewatering 12 Other (Specify below)

2 Irrigation 4 Industrial 7 Lawn and garden only 10 Monitoring well

Was a chemical/bacteriological sample submitted to Department? Yes No ☒ If yes, mo/day/yr sample was submittedWater Well Disinfected? Yes ☒ No

5 TYPE OF BLANK CASING USED:

1 Steel 3 RMP (SR) 5 Wrought iron 8 Concrete tile CASING JOINTS: Glued Clamped

2 PVC 4 ABS 6 Asbestos-Cement 9 Other (specify below) Welded

Blank casing diameter **5** in. to ft., Dia in. to ft., Dia in. to ft.Casing height above land surface **12** in., weight **160** lbs./ft. Wall thickness or gauge No.

TYPE OF SCREEN OR PERFORATION MATERIAL:

1 Steel 3 Stainless steel 5 Fiberglass 7 PVC 10 Asbestos-cement

2 Brass 4 Galvanized steel 6 Concrete tile 9 ABS 11 Other (specify)

SCREEN OR PERFORATION OPENINGS ARE: 5 Gauzed wrapped 8 Saw cut 11 None (open hole)

1 Continuous slot 3 Mill slot 6 Wire wrapped 9 Drilled holes

2 Louvered shutter 4 Key punched 7 Torch cut 10 Other (specify)

SCREEN-PERFORATED INTERVALS: From **107** ft. to **127** ft. From ft. to ft.

From ft. to ft. From ft. to ft.

GRAVEL PACK INTERVALS: From **20** ft. to **127** ft. From ft. to ft.

From ft. to ft. From ft. to ft.

6 GROUT MATERIAL: 1 Neat cement 2 Cement grout 3 Bentonite 4 Other

Grout Intervals: From **3** ft. to **20** ft. From ft. to ft. From ft. to ft.

What is the nearest source of possible contamination:

1 Septic tank 4 Lateral lines 7 Pit privy 10 Livestock pens 14 Abandoned water well

2 Sewer lines 5 Cess pool 8 Sewage lagoon 11 Fuel storage 15 Oil well/Gas well

3 Watertight sewer lines 6 Seepage pit 9 Feedyard 12 Fertilizer storage 16 Other (specify below)

Direction from well? **down slope** How many feet? **100+**

FROM TO LITHOLOGIC LOG FROM TO PLUGGING INTERVALS

0 6 dirt

6 12 green shale

12 42 shale

42 56 red rock

56 80 yellow clay

80 104 gray shale

104 112 red rock

112 127 shaley lime

7 CONTRACTOR'S OR LANDOWNER'S CERTIFICATION: This water well was (1) constructed, (2) reconstructed, or (3) plugged under my jurisdiction and was completed on (mo/day/year) **3/4/92** and this record is true to the best of my knowledge and belief. Kansas

Water Well Contractor's License No. **493** This Water Well Record was completed on (mo/day/yr)under the business name of **Kenner Well Drilling** by (signature) **Kenner**