USE TYPEWRITER OR BALL POINT PEN-PRESS FIRMLY, PRINT CLEARLY.

WATER WELL RECORD
KSA 82a-1201-1215

Kansas Department of Health and Environment-Division of Environment
(Water well Contractors)
Topeka, Kansas 66620

1. Location of well:	County	Fraction	Section number	Township number	Range number
	Butler	SE 1/4 SE 1/4 SW 1/4	29	T 28 S	R 3 E/W

X Distance and direction from nearest town or city: IN ¼ E of
Street address of well location if in city: Rose Hill KS

3. Owner of well: Jack Wilks
R.R. or street: R1 Box 177
City, state, zip code: Rose Hill KS

4. Locate with "X" in section below:

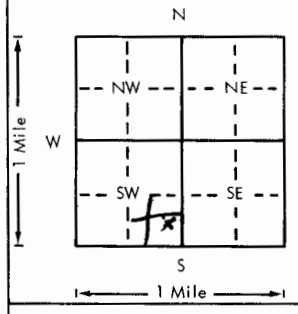

Sketch map:

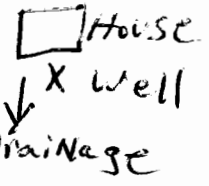

6. Bore hole dia. 8.5 in. Completion date 6-27-79
Well depth 71 ft.

7. X Cable tool __ Rotary __ Driven __ Dug
__ Hollow rod __ Jetted __ Bored __ Reverse rotary

8. Use: __ Domestic __ Public supply __ Industry
__ Irrigation __ Air conditioning __ Stock
X Lawn __ Oil field water __ Other

9. Casing: Material PVC Height: Above X below
Threaded __ Welded Glue Surface 14 in.
RMP __ PVC X Weight __ lbs./ft.
Dia. 5 in. to 71 ft. depth Wall Thickness: inches or
Dia. __ in. to __ ft. depth gage No. 200

5. Type and color of material	From	To
Top soil	0	1
clay Redish brown	1	9
clay yellow	9	28
Limestone yellow (hard)	28	34
clay yellow with gravel	34	51
Limestone yellow	51	59
Shale gray green	59	71
(A little water at 38')		
(Water at 59')		
(Use a second sheet if needed)		

10. Screen: Manufacturer's name Jet Stream
Type PVC Dia. 5"
Slot/gauze .40 Length 30'
Set between 41 ft. and 71 ft.
91 ft. and 91 ft.
Gravel pack? yes Size range of material 1/8-3/4

11. Static water level: mo./day/yr.
19 ft. below land surface Date 6-27-79

12. Pumping level below land surfaces: NA
___ ft. after ___ hrs. pumping ___ g.p.m.
___ ft. after ___ hrs. pumping ___ g.p.m.
Estimated maximum yield ___ g.p.m.

13. Water sample submitted: mo./day/yr.
__ Yes X No Date

14. Well head completion:
X Pitless adapter 14 Inches above grade

15. Well grouted? yes
With: __ Neat cement __ Bentonite X Concrete
Depth: From 13 ft. to 3 ft.

16. Nearest source of possible contamination: NA
ft. ___ Direction ___ Type ___
Well disinfected upon completion? __ Yes __ No

17. Pump: X Not installed
Manufacturer's name ___
Model number ___ HP ___ Volts ___
Length of drop pipe ___ ft. capacity ___ g.p.m.
Type:
__ Submersible __ Turbine
__ Jet __ Reciprocating
__ Centrifugal __ Other

18. Elevation:

Topography:
__ Hill
X Slope
__ Upland
__ Valley

19. Remarks:

20. Water well contractor's certification:
This well was drilled under my jurisdiction and this report is true to the best of my knowledge and belief.
Braddy water wells 363
Business name License No.
Address RR Douglass KS
Signed Richard Braddy Date 6-27-79
Authorized representative

28 T — 3 E/W R — 29 Sec — SE 1/4 SE 1/4 SW 1/4

Forward the white, blue and pink copies to the Department of Health and Environment

Form WWC-5

MI-1023