USE TYPEWRITER OR BALL POINT PEN-PRESS FIRMLY, PRINT CLEARLY.

# WATER WELL RECORD
KSA 82a-1201-1215

Kansas Department of Health and Environment-Division of Environment
(Water well Contractors)
Topeka, Kansas 66620

| 1. Location of well: | County | Fraction | Section number | Township number | Range number |
|---|---|---|---|---|---|
| | Butler | NW 1/4 NW 1/4 | 29 | T 28 S | R 3E E/W |

2. Distance and direction from nearest town or city: 1¼ E. of 143rd E. on 55th S., then ¼ S. in the field.
Street address of well location if in city:

3. Owner of well: George Clark
R.R. or street: 357 Lulu
City, state, zip code: Wichita, Kansas

4. Locate with "X" in section below:

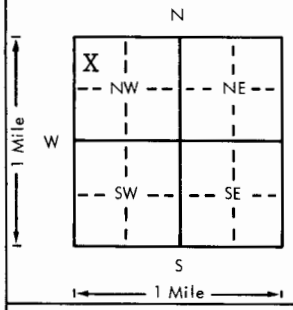


Sketch map: Wichita, Kansas

6. Bore hole dia. 11 in. Completion date ____
Well depth 85 ft. 7-19-78

7. __ Cable tool X Rotary __ Driven __ Dug
__ Hollow rod __ Jetted __ Bored __ Reverse rotary

8. Use: X Domestic __ Public supply __ Industry
__ Irrigation __ Air conditioning __ Stock
__ Lawn __ Oil field water __ Other

9. Casing: Material Styrene Height: Above or ~~below~~
Threaded ____ Welded gl Surface 12 in.
RMP X PVC ____ Weight ____ lbs./ft.
Dia. 5 in. to 85 ft. depth Wall Thickness: inches or
Dia. ____ in. to ____ ft. depth gage No. .200

| 5. Type and color of material | From | To |
|---|---|---|
| Topsoil | 0 | 3 |
| Clay | 3 | 14 |
| Brown Shale | 14 | 34 |
| Gray Shale | 34 | 85 |

(Use a second sheet if needed)

10. Screen: Manufacturer's name Sunflower Plastic
Type styrene Dia. 5"
Slot/gauze .06 Length 60'
Set between 25 ft. and 85 ft.
____ ft. and ____ ft.
Gravel pack? yes Size range of material ¼-1/8"

11. Static water level: mo./day/yr.
20 ft. below land surface Date 7-19-78

12. Pumping level below land surfaces:
____ ft. after ____ hrs. pumping ____ g.p.m.
____ ft. after ____ hrs. pumping ____ g.p.m.
Estimated maximum yield ____ g.p.m.

13. Water sample submitted: mo./day/yr.
__ Yes __ No Date ____

14. Well head completion: capped
__ Pitless adapter 12 Inches above grade

15. Well grouted? yes 1-2Fine Sand Mix
With: __ Neat cement __ Bentonite X Concrete
Depth: From 40" ft. to 14 ft.

16. Nearest source of possible contamination:
ft. ____ Direction ____ Type NONE
Well disinfected upon completion? X Yes __ No

17. Pump: X Not installed
Manufacturer's name ____
Model number ____ HP ____ Volts ____
Length of drop pipe ____ ft. capacity ____ g.p.m.
Type:
__ Submersible __ Turbine
__ Jet __ Reciprocating
__ Centrifugal __ Other

18. Elevation:

Topography:
__ Hill
__ Slope
__ Upland
__ Valley

19. Remarks: Flat Ground

Septic system not installed at this time.
No apparent source for contamination.

20. Water well contractor's certification:
This well was drilled under my jurisdiction and this report is true to the best of my knowledge and belief.
Harp Well & Pump 236
Business name License No.
Address Wichita, Kansas 67209
Signed M. Arnold Date 8-1-78
Authorized representative

28 T 3 R 30 E W 29 Sec NW 1/4 NW 1/4 NW 1/4

Forward the white, blue and pink copies to the Department of Health and Environment

Form WWC-5

MI-1023