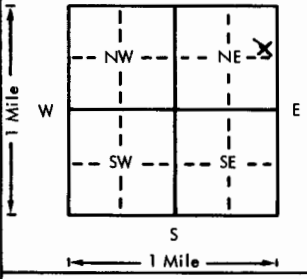
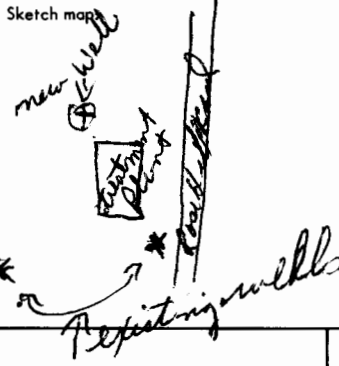


USE TYPEWRITER OR BALL  
POINT PEN-PRESS FIRMLY,  
PRINT CLEARLY.

WATER WELL RECORD  
KSA 82a-1201-1215

Kansas Department of Health and  
Environment-Division of Environment  
(Water well Contractors)  
Topeka, Kansas 66620

1. Location of well:		County <b>BUTLER</b>	Fraction <b>NE 1/4 NE 1/4 NE 1/4</b>	Section number <b>30</b>	Township number <b>T 28 S</b>	Range number <b>R 30 E</b>
2. Distance and direction from nearest town or city: <b>2 mi north of Rose Hill KS</b>		3. Owner of well: <b>City of Rose Hill</b>		R.R. or street: <b>ROSE HILL KS</b>		
4. Locate with "X" in section below:		Sketch map:		6. Bore hole dia. <b>12</b> in. Completion date <b>Sept 12, 1976</b>		
				Well depth <b>58</b> ft.		
5. Type and color of material		From	To	7. <input checked="" type="checkbox"/> Cable tool <input type="checkbox"/> Rotary <input type="checkbox"/> Driven <input type="checkbox"/> Dug		
<b>Brown Surface clay</b>		<b>0</b>	<b>6</b>	<input type="checkbox"/> Hollow rod <input type="checkbox"/> Jetted <input type="checkbox"/> Bored <input type="checkbox"/> Reverse rotary		
<b>Yellow clay</b>		<b>7</b>	<b>25</b>	8. Use: <input type="checkbox"/> Domestic <input checked="" type="checkbox"/> Public supply <input type="checkbox"/> Industry		
<b>Yellow water shale</b>		<b>26</b>	<b>28</b>	<input type="checkbox"/> Irrigation <input type="checkbox"/> Air conditioning <input type="checkbox"/> Stock		
<b>Yellow clay</b>		<b>29</b>	<b>38</b>	<input type="checkbox"/> Lawn <input type="checkbox"/> Oil field water <input type="checkbox"/> Other		
<b>Light Gray water shale</b>		<b>39</b>	<b>42</b>	9. Casing: Material <b>PVC</b> Height: Above or below		
<b>Light Gray clay</b>		<b>42</b>	<b>50</b>	Threading <input type="checkbox"/> Welded <input type="checkbox"/> Surface <b>24</b> in.		
<b>Gray water shale</b>		<b>51</b>	<b>52</b>	RMP <input type="checkbox"/> PVC <input checked="" type="checkbox"/> Weight <input type="checkbox"/> lbs./ft.		
<b>Gray clay</b>		<b>53</b>	<b>58</b>	Dia. <b>2</b> in. to <b>38</b> ft. depth Wall Thickness: inches or		
				Dia. <input type="checkbox"/> in. to <input type="checkbox"/> ft. depth gage No. <input type="checkbox"/>		
				10. Screen: Manufacturer's name <input type="checkbox"/>		
				Type <b>PVC</b> Dia. <b>8"</b>		
				Slot gauge <input type="checkbox"/> Length <b>20 ft</b>		
				Set between <b>38</b> ft. and <b>58</b> ft.		
				Gravel pack? <input checked="" type="checkbox"/> Size range of material <b>3/8" sand</b>		
				11. Static water level: <input type="checkbox"/> mo./day/yr.		
				<b>4</b> ft. below land surface Date <b>9/12/76</b>		
				12. Pumping level below land surfaces:		
				<input type="checkbox"/> ft. after <input type="checkbox"/> hrs. pumping <input type="checkbox"/> g.p.m.		
				<input type="checkbox"/> ft. after <input type="checkbox"/> hrs. pumping <input type="checkbox"/> g.p.m.		
				Estimated maximum yield <b>100</b> g.p.m.		
				13. Water sample submitted: <input type="checkbox"/> mo./day/yr.		
				Yes <input checked="" type="checkbox"/> No <input type="checkbox"/> Date <input type="checkbox"/>		
				14. Well head completion:		
				<input type="checkbox"/> Pitless adapter <b>24</b> inches above grade		
				15. Well grouted? <b>yes</b>		
				With: <input checked="" type="checkbox"/> Neat cement <input type="checkbox"/> Bentonite <input type="checkbox"/> Concrete		
				Depth: From <input type="checkbox"/> ft. to <b>20</b> ft.		
				16. Nearest source of possible contamination:		
				ft. <b>None</b> Direction <input type="checkbox"/> Type <input type="checkbox"/>		
				Well disinfected upon completion? <input checked="" type="checkbox"/> Yes <input type="checkbox"/> No		
				17. Pump:		
				<input checked="" type="checkbox"/> Not installed		
				Manufacturer's name <input type="checkbox"/>		
				Model number <input type="checkbox"/> HP <input type="checkbox"/> Volts <input type="checkbox"/>		
				Length of drop pipe <input type="checkbox"/> ft. capacity <input type="checkbox"/> g.p.m.		
				Type:		
				<input type="checkbox"/> Submersible <input type="checkbox"/> Turbine		
				<input type="checkbox"/> Jet <input type="checkbox"/> Reciprocating		
				<input type="checkbox"/> Centrifugal <input type="checkbox"/> Other		
18. Elevation:		19. Remarks:		20. Water well contractor's certification:		
Topography:				This well was drilled under my jurisdiction and this report		
<input type="checkbox"/> Hill				is true to the best of my knowledge and belief		
<input type="checkbox"/> Slope				<b>Jimmons Drilling</b>		
<input type="checkbox"/> Upland				Business name <input type="checkbox"/> License No. <input type="checkbox"/>		
<input checked="" type="checkbox"/> Valley				Address <b>155 East Anderson</b>		
				Signed <b>Bob Bruegg</b> Date <b>9/12/76</b>		
				Authorized representative		

Forward the white, blue and pink copies to the Department of Health and Environment

Form WWC-5