


1 LOCATION OF WATER WELL: Fraction SE 1/4 NW 1/4 SW 1/4 Section Number 30 Township Number T 28 S Range Number R 3 E
 County: Butler

Distance and direction from nearest town or city street address of well if located within city?

Crow Aoad Rosehill Rd & 63rd 1 W. 1/4 N E. Side Rd

2 WATER WELL OWNER: Larry Peer
 RR#, St. Address, Box #: 1501 Phyllis
 City, State, ZIP Code: Andover KS 67002
 Board of Agriculture, Division of Water Resources
 Application Number:

3 LOCATE WELL'S LOCATION WITH AN "X" IN SECTION BOX: 4 DEPTH OF COMPLETED WELL: 86 ft. ELEVATION: 86 ft.

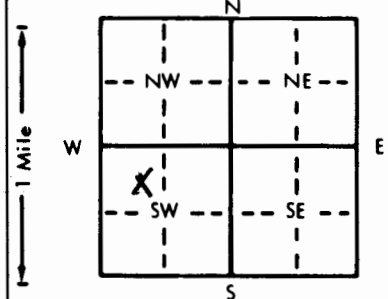

Depth(s) Groundwater Encountered 1. 25 ft. 2. 60 ft. 3. August 4, 1988 ft.

WELL'S STATIC WATER LEVEL 25 ft. below land surface measured on mo/day/yr August 4, 1988

Pump test data: Well water was _____ ft. after _____ hours pumping _____ gpm

Est. Yield 20 gpm Well water was _____ ft. after _____ hours pumping _____ gpm

Bore Hole Diameter 10 in. to _____ ft., and _____ in. to _____ ft.

WELL WATER TO BE USED AS: 5 Public water supply 8 Air conditioning 11 Injection well

1 Domestic 3 Feedlot 6 Oil field water supply 9 Dewatering 12 Other (Specify below)

2 Irrigation 4 Industrial 7 Lawn and garden only 10 Monitoring well

Was a chemical/bacteriological sample submitted to Department? Yes No; If yes, mo/day/yr sample was submitted

Water Well Disinfected? Yes No

5 TYPE OF BLANK CASING USED: 5 Wrought iron 8 Concrete tile CASING JOINTS: Glued Clamped
 1 Steel 3 RMP (SR) 6 Asbestos-Cement 9 Other (specify below) Welded
 2 PVC 4 ABS 7 Fiberglass Threaded

Blank casing diameter 5 in. to _____ ft., Dia 200 in. to _____ ft., Dia _____ in. to _____ ft.

Casing height above land surface 12 in., weight _____ lbs./ft. Wall thickness or gauge No. _____

TYPE OF SCREEN OR PERFORATION MATERIAL: 7 PVC 10 Asbestos-cement

1 Steel 3 Stainless steel 5 Fiberglass 8 RMP (SR) 11 Other (specify)

2 Brass 4 Galvanized steel 6 Concrete tile 9 ABS 12 None used (open hole)

SCREEN OR PERFORATION OPENINGS ARE: 5 Gauzed wrapped 8 Saw cut 11 None (open hole)

1 Continuous slot 3 Mill slot 6 Wire wrapped 9 Drilled holes

2 Louvered shutter 4 Key punched 7 Torch cut 10 Other (specify)

SCREEN-PERFORATED INTERVALS: From 66 ft. to 86 ft., From _____ ft. to _____ ft.

From _____ ft. to _____ ft., From _____ ft. to _____ ft.

GRAVEL PACK INTERVALS: From 20 ft. to 86 ft., From _____ ft. to _____ ft.

From _____ ft. to _____ ft., From _____ ft. to _____ ft.

6 GROUT MATERIAL: 1 Neat cement 2 Cement grout 3 Bentonite 4 Other

Grout Intervals: From 3 ft. to 20 ft., From _____ ft. to _____ ft., From _____ ft. to _____ ft.

What is the nearest source of possible contamination:

1 Septic tank 4 Lateral lines 7 Pit privy 10 Livestock pens 14 Abandoned water well

2 Sewer lines 5 Cess pool 8 Sewage lagoon 11 Fuel storage 15 Oil well/Gas well

3 Watertight sewer lines 6 Seepage pit 9 Feedyard 12 Fertilizer storage 16 Other (specify below)

Direction from well? Down Slope How many feet? 475

FROM TO LITHOLOGIC LOG FROM TO PLUGGING INTERVALS

0 2 earth

2 7 gum 60

7 10 red clay

10 25 brown clay

25 60 yellow clay

60 86 grey shale

7 CONTRACTOR'S OR LANDOWNER'S CERTIFICATION: This water well was (1) constructed, (2) reconstructed, or (3) plugged under my jurisdiction and was completed on (mo/day/year) August 4, 1988 and this record is true to the best of my knowledge and belief. Kansas Water Well Contractor's License No. 775 This Water Well Record was completed on (mo/day/yr) August 4, 1988 under the business name of Raiser Well Drilling by (signature) James Raiser