


1 LOCATION OF WATER WELL: County: Butler Fraction: NW 1/4 SW 1/4 SW 1/4 Section Number: 30 Township Number: T 28 S Range Number: R 3 E

Distance and direction from nearest town or city street address of well if located within city? CROW Add. from R.H. Rd + 63rd 1 W-1/4 N. E side

2 WATER WELL OWNER: Boone Mounivong RR#, St. Address, Box #: 2908 So. Custer City, State, ZIP Code: Wichita, KS 67217 Board of Agriculture, Division of Water Resources Application Number:

3 LOCATE WELL'S LOCATION WITH AN "X" IN SECTION BOX: 4 DEPTH OF COMPLETED WELL: 80 ft. ELEVATION: 20 ft. below land surface measured on mo/day/yr July 8, 1988

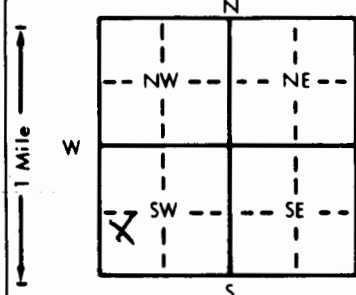

Depth(s) Groundwater Encountered 1. 30 ft. 2. 65 ft. 3. 80 ft.
WELL'S STATIC WATER LEVEL 20 ft. below land surface measured on mo/day/yr July 8, 1988
Bore Hole Diameter 10 in. to 10 ft. and 10 in. to 10 ft.
WELL WATER TO BE USED AS:
1 Domestic 1 3 Feedlot 1 6 Oil field water supply 1 9 Dewatering 1 12 Other (Specify below)
2 Irrigation 1 4 Industrial 1 7 Lawn and garden only 1 10 Monitoring well 1
Was a chemical/bacteriological sample submitted to Department? Yes No If yes, mo/day/yr sample was submitted No
Water Well Disinfected? Yes Yes No

5 TYPE OF BLANK CASING USED:
1 Steel 3 RMP (SR) 5 Wrought iron 8 Concrete tile CASING JOINTS: Glued Clamped
2 PVC 4 ABS 6 Asbestos-Cement 9 Other (specify below) Welded
3 Fiberglass Threaded

Casing height above land surface 712 in., weight 200 lbs./ft. Wall thickness or gauge No.

TYPE OF SCREEN OR PERFORATION MATERIAL:
1 Steel 3 Stainless steel 5 Fiberglass 8 RMP (SR) 10 Asbestos-cement
2 Brass 4 Galvanized steel 6 Concrete tile 9 ABS 11 Other (specify)
12 None used (open hole)

SCREEN OR PERFORATION OPENINGS ARE:
1 Continuous slot 3 Mill slot 5 Gauzed wrapped 8 Saw cut 11 None (open hole)
2 Louvered shutter 4 Key punched 6 Wire wrapped 9 Drilled holes
7 Torch cut 10 Other (specify)


6 GROUT MATERIAL: 1 Neat cement 2 Cement grout 3 Bentonite 4 Other

What is the nearest source of possible contamination:
1 Septic tank 1 4 Lateral lines 7 Pit privy 10 Livestock pens 14 Abandoned water well
2 Sewer lines 5 Cess pool 8 Sewage lagoon 11 Fuel storage 15 Oil well/Gas well
3 Watertight sewer lines 6 Seepage pit 9 Feedyard 12 Fertilizer storage 16 Other (specify below)
13 Insecticide storage

Direction from well? Down slope How many feet? 100

FROM	TO	LITHOLOGIC LOG	FROM	TO	PLUGGING INTERVALS
0	3	earth			
3	8	gumbo			
8	12	red clay			
12	30	brown clay			
30	65	yellow clay			
65	80	gray shale			

7 CONTRACTOR'S OR LANDOWNER'S CERTIFICATION: This water well was (1) constructed, (2) reconstructed, or (3) plugged under my jurisdiction and was completed on (mo/day/year) July 8, 1988 and this record is true to the best of my knowledge and belief. Kansas Water Well Contractor's License No. 473 This Water Well Record was completed on (mo/day/yr) July 30, 1988 under the business name of Reiserer Well Drilling (signature) John Reiserer