

USE TYPEWRITER OR BALL
POINT PEN-PRESS FIRMLY,
PRINT CLEARLY.

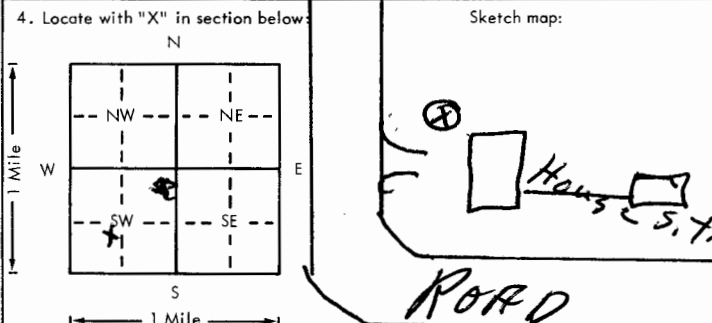
Well #6

Lot 3 R.R.D

WATER WELL RECORD
KSA 82a-1201-1215

Kansas Department of Health and
Environment-Division of Environment
(Water well Contractors)
Topeka, Kansas 66620

Hillwood Addition to Butler County

1. Location of well:		County BUTLER	Fraction NE 1/4 SW 1/4 SW 1/4	Section number 33	Township number T 28 S	Range number R 13 E
2. Distance and direction from nearest town or city:		1 1/2 E. of Rose Hill 1/2 N.D.		3. Owner of well: Kirk Hayden R.R. or street: 100 E. Silkknitter City, state, zip code: Rose Hill, Kansas 67133		
4. Locate with "X" in section below		Sketch map:		6. Bore hole dia. 10 1/8 in. Completion date 6-13 Well depth 86 ft.		
				7. ☒ Cable tool ☒ Rotary ☐ Driven ☐ Dug ☐ Hollow rod ☐ Jetted ☐ Bored ☐ Reverse rotary		
5. Type and color of material		From		To		8. Use: ☒ Domestic ☐ Public supply ☐ Industry ☐ Irrigation ☐ Air conditioning ☐ Stock ☐ Lawn ☐ Oil field water ☐ Other
Top Soil		0		2		9. Casing: Material PVC Height: Above or below Threaded ☐ Welded ☐ Surface 14 in. RMP ☐ PVC 6.6 Weight ☐ lbs./ft.
Red Clay		2		14		Dia. 5 in. to 76 ft. depth Wall Thickness: inches or Dia. 5 in. to 76 ft. depth gauge No. 758
SHALE (GRAY)		14		86		10. Screen: Manufacturer's name M. P. L. Type P.V.C. Dia. 5 Slot/gauge 25/1000 Length 66 ft. Set between 76 ft. and 86 ft. Gravel pack? yes Size range of material 7/8
						11. Static water level: 19 ft. below land surface Date 6-13-78 mo./day/yr.
						12. Pumping level below land surfaces: ____ ft. after ____ hrs. pumping ____ g.p.m. ____ ft. after ____ hrs. pumping ____ g.p.m. Estimated maximum yield 20 g.p.m.
						13. Water sample submitted: ____ mo./day/yr. Yes ☒ No ☐ Date
						14. Well head completion: CAP ____ Pitless adapter 14 Inches above grade
						15. Well grouted? yes With: ☒ Neat cement ☐ Bentonite ☐ Concrete Depth: From 22 ft. to 14 ft.
						16. Nearest source of possible contamination: ft. 90 Direction W Type s.t. Well disinfected upon completion? ☒ Yes ☐ No
						17. Pump: ☒ Not installed Manufacturer's name Model number ____ HP ____ Volts ____ Length of drop pipe ____ ft. capacity ____ g.p.m. Type: ____ Submersible ____ Turbine ____ Jet ____ Reciprocating ____ Centrifugal ____ Other
18. Elevation:		19. Remarks:		20. Water well contractor's certification:		
Topography: ☐ Hill ☐ Slope ☒ Upland ☐ Valley		Well #6 Owner will install concrete 4'x4'x4" slab. <i>Don E. Hayden</i>		This well was drilled under my jurisdiction and this report is true to the best of my knowledge and belief. <i>Phurt Const.</i> 353 Business name License No. Address Box 744 Signed <i>Arthur E. Phurt</i> Date 6-13-78 Authorized representative		

Forward the white, blue and pink copies to the Department of Health and Environment

Form WWC-5