

USE TYPEWRITER OR BALL
POINT PEN-PRESS FIRMLY,
PRINT CLEARLY.

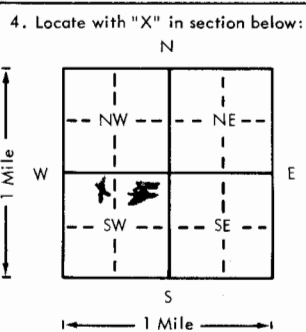
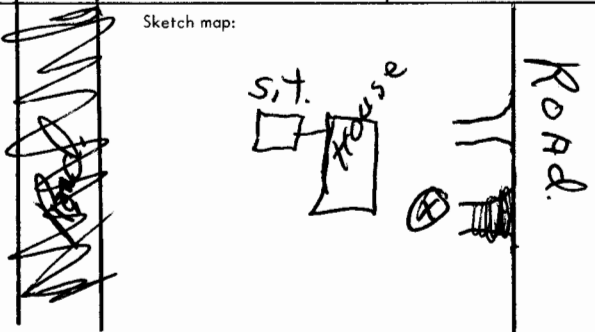
Well #4

WATER WELL RECORD
KSA 82a-1201-1215

lot 2 BLK H

Kansas Department of Health and
Environment-Division of Environment
(Water well Contractors)
Topeka, Kansas 66620

Hillwood Addition to Butler County

1. Location of well:		County Butler	Fraction NE 1/4 SW 1/4 SW 1/4	Section number 33	Township number T 28	Range number S 3	EW
2. Distance and direction from nearest town or city:		1 1/2 E of Rine Hill 1/2 MO.		3. Owner of well: Don Bigelow R.R. or street: 2321 Gilmore Dr. City, state, zip code: Wichita, Kansas 67228			
4. Locate with "X" in section below:		Sketch map:		6. Bore hole dia. 10 3/8 in. Completion date 6-13-78 Well depth 80 ft.			
				7. Cable tool ☒ Rotary ☐ Driven ☐ Dug ☐ Hollow rod ☐ Jetted ☐ Bored ☐ Reverse rotary			
5. Type and color of material		From		To		8. Use: ☒ Domestic ☐ Public supply ☐ Industry ☐ Irrigation ☐ Air conditioning ☐ Stock ☐ Lawn ☐ Oil field water ☐ Other	
Top Soil		0		2		9. Casing: Material PVC Height: Above or below Threaded ☐ Welded ☐ Surface 16 in. RMP ☐ PVC GL Weight ☐ lbs./ft.	
Red Clay		2		8		Dia. 5 in. to 70 ft. depth Wall Thickness: inches or Dia. ☐ in. to ☐ ft. depth gage No. 250	
Lime Stone		8		14		10. Screen: Manufacturer's name M.P.L. Type P.V.C Dia. 5 Slot/gauze 25/1000 Length 10 Set between 70 ft. and 80 ft. Gravel pack? yes Size range of material 7/16	
SHALE (GRAY)		14		80		11. Static water level: ☐ mo./day/yr. 12 ft. below land surface Date 6-13-78	
						12. Pumping level below land surfaces: ____ ft. after ____ hrs. pumping ____ g.p.m. ____ ft. after ____ hrs. pumping ____ g.p.m. Estimated maximum yield 20 g.p.m.	
						13. Water sample submitted: ____ mo./day/yr. Yes ☒ No ☐ Date ____	
						14. Well head completion: CAP ____ Pitless adapter 16 inches above grade	
						15. Well grouted? yes With: ☒ Neat cement ☐ Bentonite ☐ Concrete Depth: From 2 1/2 ft. to 14 ft.	
						16. Nearest source of possible contamination: ft. 90 Direction NO Type S.T. Well disinfected upon completion? ☒ Yes ☐ No	
						17. Pump: ☒ Not installed Manufacturer's name ____ Model number ____ HP ____ Volts ____ Length of drop pipe ____ ft. capacity ____ g.p.m. Type: ____ Submersible ____ Turbine ____ Jet ____ Reciprocating ____ Centrifugal ____ Other	
18. Elevation:		19. Remarks:		20. Water well contractor's certification: This well was drilled under my jurisdiction and this report is true to the best of my knowledge and belief. Phurst Const. 353 Business name Box 744 License No. ____ Address Don E. Phurst Signed Don E. Phurst Date 6-13-78 Authorized representative			
Topography: ☐ Hill ☐ Slope ☒ Upland ☐ Valley		Well #4 Owner will install 4 x 4 x 4" concrete slab. Don E. Phurst					