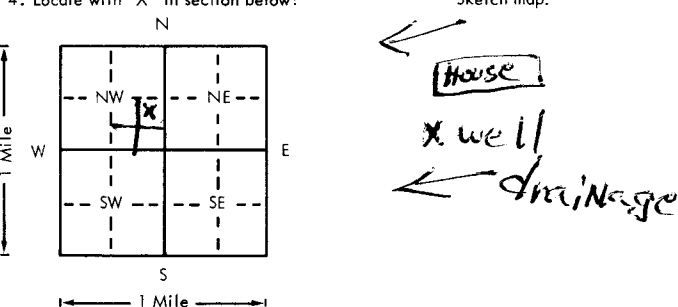


USE TYPEWRITER OR BALL
POINT PEN-PRESS FIRMLY,
PRINT CLEARLY.

WATER WELL RECORD
KSA 82a-1201-1215

Kansas Department of Health and
Environment-Division of Environment
(Water well Contractors)
Topeka, Kansas 66620

1. Location of well: County <u>Butler</u> Fraction <u>NE 1/4 SE 1/4 NW 1/4</u> Section number <u>33</u> Township number <u>T 28 S</u> Range number <u>R 3 E</u>	
2. Distance and direction from nearest town or city: <u>1 1/2 E 1/2 N of Rose Hill Ks</u> Street address of well location if in city: <u>2411 Dawn Hill Trailwood</u>	
3. Owner of well: <u>Wayne Williams</u> R.R. or street: <u>535 N Oliver</u> City, state, zip code: <u>Wichita Ks. 67208</u>	
4. Locate with "X" in section below: Sketch map: 	
5. Type and color of material	
Clay brown	From 0 To 3
Clay with limestone yellow	3 10
Limestone yellow (Hard)	10 15
clay yellow green	15 27
shale light gray	27 42
shale blue gray	42 69
(Water at 47')	
6. Bore hole dia. <u>8.5</u> in. Completion date <u>5-15-79</u> Well depth <u>69</u> ft.	
7. ☒ Cable tool ☐ Rotary ☐ Driven ☐ Dug ☐ Hollow rod ☐ Jetted ☐ Bored ☐ Reverse rotary	
8. Use: ☒ Domestic ☐ Public supply ☐ Industry ☐ Irrigation ☐ Air conditioning ☐ Stock ☐ Lawn ☐ Oil field water ☐ Other	
9. Casing: Material <u>PITS</u> Height: Above <u>below</u> Threaded ☐ Welded <u>gk</u> Surface <u>14</u> in. RMP ☒ PVC ☐ Weight <u> </u> lbs./ft. Dia. <u>5</u> in. to <u>69</u> ft. depth Wall Thickness: inches or Dia. <u> </u> in. to <u> </u> ft. depth gage No. <u>200</u>	
10. Screen: Manufacturer's name <u>SCAFLOWER</u> <u>MEG</u> Type <u>RMP</u> Dia. <u>5 1/4</u> Slot/gauze <u>1/16</u> Length <u>10'</u> Set between <u>59</u> ft. and <u>69</u> ft. <u> </u> ft. and <u> </u> ft. Gravel pack? ☒ Size range of material <u>14-34</u>	
11. Static water level: <u>27</u> ft. below land surface Date <u>5-15-79</u> mo./day/yr.	
12. Pumping level below land surfaces: <u>NA</u> <u> </u> ft. after <u> </u> hrs. pumping <u> </u> g.p.m. <u> </u> ft. after <u> </u> hrs. pumping <u> </u> g.p.m. Estimated maximum yield <u> </u> g.p.m.	
13. Water sample submitted: <u> </u> mo./day/yr. <u> </u> Yes ☒ No <u> </u> Date <u> </u>	
14. Well head completion: ☒ Pitless adapter <u>14</u> inches above grade	
15. Well grouted? <u>yes</u> With: <u> </u> Neat cement <u> </u> Bentonite ☒ Concrete Depth: From <u>14</u> ft. to <u>4</u> ft.	
16. Nearest source of possible contamination: <u>NA</u> ft. <u> </u> Direction <u> </u> Type <u> </u> Well disinfected upon completion? ☒ Yes <u> </u> No	
17. Pump: ☒ Not installed Manufacturer's name <u> </u> Model number <u> </u> HP <u> </u> Volts <u> </u> Length of drop pipe <u> </u> ft. capacity <u> </u> g.p.m. Type: <u> </u> Submersible <u> </u> Turbine <u> </u> Jet <u> </u> Reciprocating <u> </u> Centrifugal <u> </u> Other	
(Use a second sheet if needed)	
18. Elevation: Topography: ☒ Hill <u> </u> Slope <u> </u> Upland <u> </u> Valley	19. Remarks: <u>owner will install concrete slab</u>
20. Water well contractor's certification: This well was drilled under my jurisdiction and this report is true to the best of my knowledge and belief. <u>Brady Water Wells 363</u> Business name <u> </u> License No. <u> </u> Address <u>R2 box 217A Dusk 535</u> Signed <u>Richard Brady</u> Date <u>5-15-79</u> Authorized representative	

Forward the white, blue and pink copies to the Department of Health and Environment

Form WWC-5