

USE TYPEWRITER OR BALL
POINT PEN-PRESS FIRMLY,
PRINT CLEARLY.

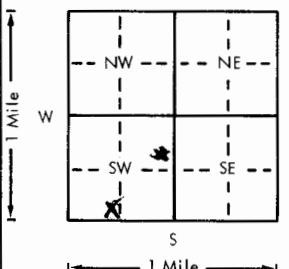
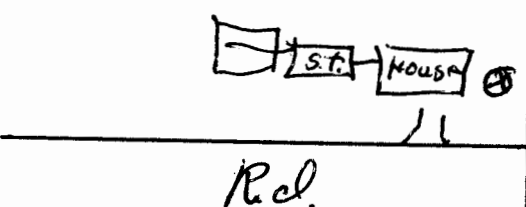
Well #8

Lot 4 Blk D

WATER WELL RECORD
KSA 82a-1201-1215

Kansas Department of Health and
Environment-Division of Environment
(Water well Contractors)
Topeka, Kansas 66620

Hillwood Addition to Butler County

1. Location of well:	County BUTLER	Fraction SE 1/4 SW 1/4 SW 1/4	Section number 33	Township number T 28 S	Range number R 13 E
2. Distance and direction from nearest town or city: 1 1/2 E. Rose	3. Owner of well: Hayden Development		R.R. or street: 100 E. Silkknitter		
Street address of well location if in city: Hill 1/2 No.		City, state, zip code: Rose Hill, KS 67133			
4. Locate with "X" in section below:		Sketch map:		6. Bore hole dia. 10 3/8 in. Completion date 6-14-78	
				Well depth 46 ft.	
5. Type and color of material		From	To	7. Cable tool ☒ Rotary ☐ Driven ☐ Dug	
TOP SOIL		0	2	☐ Hollow rod ☐ Jetted ☐ Bored ☐ Reverse rotary	
Red CLAY		2	14	8. Use: ☒ Domestic ☐ Public supply ☐ Industry	
Red Rock		14	18	☐ Irrigation ☐ Air conditioning ☐ Stock	
SHALE (GRAY)		18	46	☐ Lawn ☐ Oil field water ☐ Other	
				9. Casing: Material P.V.C. Height: 14 or below	
				Threaded ☐ Welded ☐ Surface 14 in.	
				RMP PVC 36 Weight 10 lbs./ft.	
				Dia. 5 in. to 36 ft. depth Wall Thickness: inches or	
				Dia. 5 in. to 36 ft. depth Gauge No. 250	
				10. Screen: Manufacturer's name M.P.L.	
				Type P.V.C. Dia. 5	
				Slot gauge 25/1000 Length 10	
				Set between 36 ft. and 46 ft.	
				Gravel pack? ☒ Size range of material 5/16	
				11. Static water level: 17 ft. below land surface Date 6-14-78	
				12. Pumping level below land surfaces:	
				____ ft. after ____ hrs. pumping ____ g.p.m.	
				____ ft. after ____ hrs. pumping ____ g.p.m.	
				Estimated maximum yield 13 g.p.m.	
				13. Water sample submitted: ____ mo./day/yr.	
				____ Yes ☒ No Date CAP	
				14. Well head completion: CAP	
				____ Pitless adapter 14 inches above grade	
				15. Well grouted? Yes	
				With: ☒ Neat cement ☐ Bentonite ☐ Concrete	
				Depth: From 2 1/2 ft. to 13 ft.	
				16. Nearest source of possible contamination:	
				ft. 60 Direction E Type S.T.	
				☒ Well disinfected upon completion? ☒ Yes ☐ No	
				17. Pump: ☒ Not installed	
				Manufacturer's name _____	
				Model number _____ HP _____ Volts _____	
				Length of drop pipe _____ ft. capacity _____ g.p.m.	
				Type:	
				☐ Submersible ☐ Turbine	
				☐ Jet ☐ Reciprocating	
				☐ Centrifugal ☐ Other	
18. Elevation:		19. Remarks: Well #8		20. Water well contractor's certification:	
Topography:		Owner will install		This well was drilled under my jurisdiction and this report	
☐ Hill		concrete slab 4'x4'x4"		is true to the best of my knowledge and belief.	
☒ Slope		Don E. Hayden		Phunt Conrath 353	
☐ Upland				Business name Boz 744 License No. _____	
☐ Valley				Address _____	
				Signed Justin C. New Date 6-14-78	
				Authorized representative	