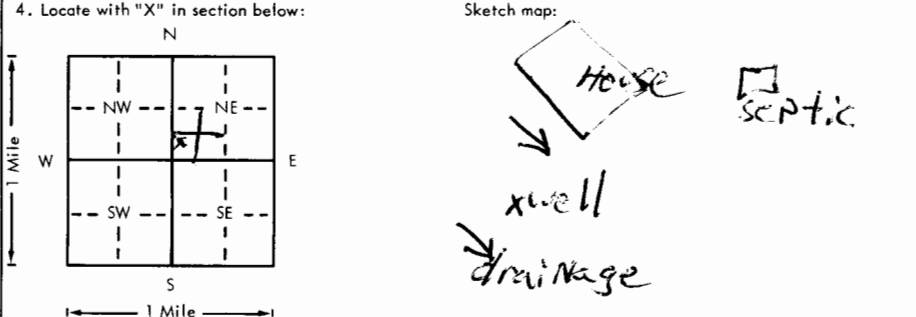


USE TYPEWRITER OR BALL
POINT PEN-PRESS FIRMLY,
PRINT CLEARLY.

WATER WELL RECORD
KSA 82a-1201-1215

Kansas Department of Health and
Environment-Division of Environment
(Water well Contractors)
Topeka, Kansas 66620

1. Location of well: County <u>Butler</u> Fraction <u>SW 1/4 SW 1/4 NE 1/4</u> Section number <u>33</u> Township number <u>T 28 S</u> Range number <u>R 3 E</u>	
2. Distance and direction from nearest town or city: <u>1 1/2 E. 1/2 N. of Rose Hill Ks.</u> Street address of well location if in city: <u></u>	
3. Owner of well: <u>Taylor Brock</u> R.R. or street: <u>Rd 1 Rose Hill Ks 67133</u> City, state, zip code: <u></u>	
4. Locate with "X" in section below: Sketch map: 	
5. Type and color of material	
6. Bore hole dia. <u>9</u> in. Completion date <u>10-19-78</u> Well depth <u>123</u> ft.	
7. ☒ Cable tool ☐ Rotary ☐ Driven ☐ Dug ☐ Hollow rod ☐ Jetted ☐ Bored ☐ Reverse rotary	
8. Use: ☒ Domestic ☐ Public supply ☐ Industry ☐ Irrigation ☐ Air conditioning ☐ Stock ☐ Lawn ☐ Oil field water ☐ Other	
9. Casing: Material <u>PST</u> Height: Above or below Threading <u>Welded</u> Surface <u>12</u> in. RMP <u>X</u> PVC <u></u> Weight <u>10</u> lbs./ft. Dia. <u>5</u> in. to <u>123</u> ft. depth Wall Thickness: inches or Dia. <u></u> in. to <u></u> ft. depth Gauge No. <u>200</u>	
10. Screen: Manufacturer's name <u>Synflow</u> Type <u>RMP</u> Dia. <u>5"</u> Slot/gauze <u>3/64</u> Length <u>10'</u> Set between <u>11.3</u> ft. and <u>12.3</u> ft. <u>49'</u> ft. and <u>50'</u> ft. Gravel pack? <u>Yes</u> Size range of material <u>14-24</u>	
11. Static water level: <u>32</u> ft. below land surface Date <u>10-19-78</u> mo./day/yr.	
12. Pumping level below land surfaces: <u>NA</u> ft. after <u></u> hrs. pumping <u></u> g.p.m. <u></u> ft. after <u></u> hrs. pumping <u></u> g.p.m. Estimated maximum yield <u></u> g.p.m.	
13. Water sample submitted: <u>X</u> Yes <u></u> No Date <u></u> mo./day/yr.	
14. Well head completion: ☒ Pitless adapter <u></u> inches above grade	
15. Well grouted? <u>yes</u> With: <u></u> Neat cement <u></u> Bentonite ☒ Concrete Depth: From <u>13</u> ft. to <u>3</u> ft.	
16. Nearest source of possible contamination: ft. <u>200</u> Direction <u>NE</u> Type <u>septic</u> Well disinfected upon completion? ☒ Yes ☐ No	
17. Pump: ☒ Not installed Manufacturer's name <u></u> Model number <u></u> HP <u></u> Volts <u></u> Length of drop pipe <u></u> ft. capacity <u></u> g.p.m. Type: ☐ Submersible ☐ Turbine ☐ Jet ☐ Reciprocating ☐ Centrifugal ☐ Other	
18. Elevation: Topography: ☒ Hill ☒ Slope ☐ Upland ☐ Valley	
19. Remarks: <u>owner will install concrete slab</u>	
20. Water well contractor's certification: This well was drilled under my jurisdiction and this report is true to the best of my knowledge and belief. Business name <u>Braddy Water Wells 363</u> License No. <u></u> Address <u>Box 217A Douglas Ks</u> Signed <u>Richard Braddy</u> Date <u>10-19-78</u> Authorized representative	

Forward the white, blue and pink copies to the Department of Health and Environment

Form WWC-5