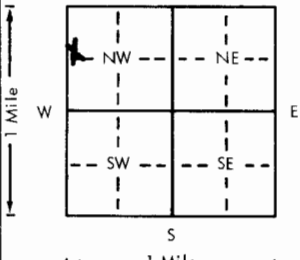


USE TYPEWRITER OR BALL
POINT PEN-PRESS FIRMLY,
PRINT CLEARLY.

WATER WELL RECORD
KSA 82a-1201-1215

Kansas Department of Health and
Environment-Division of Environment
(Water well Contractors)
Topeka, Kansas 66620

1. Location of well:	County Butler	Fraction 1/4 NW 1/4 NW 1/4	Section number 36	Township number T 28 S	Range number R 3E E/W
2. Distance and direction from nearest town or city: 4 miles East of Rose Hill, KS, 1/4 mile South Street address of well location if in city: of 63rd South on the East side of the road.			3. Owner of well: John Shelton R.R. or street: 4440 Bellaire City, state, zip code: Wichita, Kansas		
4. Locate with "X" in section below: N  W E S 1 Mile			Sketch map: 6. Bore hole dia. 11 in. Completion date 12-12-78 Well depth 142 ft. 7. ☒ Cable tool ☒ Rotary ☐ Driven ☐ Dug ☐ Hollow rod ☐ Jetted ☐ Bored ☐ Reverse rotary 8. Use: ☒ Domestic ☐ Public supply ☐ Industry ☐ Irrigation ☐ Air conditioning ☐ Stock ☐ Lawn ☐ Oil field water ☐ Other 9. Casing: Material Styrene Height: Above or below Threaded ☐ Welded ☒ Surface 12 in. RMP ☒ PVC ☐ Weight ☐ lbs./ft. Dia. 5 in. to 142 ft. depth Wall Thickness: inches or Dia. ☐ in. to ☐ ft. depth gage No. 200		
5. Type and color of material			From	To	
Topsoil			0	2	10. Screen: Manufacturer's name Sunflower plastic Type styrene Dia. 5" Slot/size .06 Length 60' Set between 82 ft. and 142 ft. ft. and ☐ ft. and ☐ ft. Gravel pack? yes Size range of material 1/4-1/8"
Clay			2	10	11. Static water level: 80 ft. below land surface Date 12-12-79 mo./day/yr.
Sandstone			10	20	12. Pumping level below land surfaces: ft. after ☐ hrs. pumping ☐ g.p.m. ft. after ☐ hrs. pumping ☐ g.p.m. Estimated maximum yield ☐ g.p.m.
Hard blue shale			20	60	13. Water sample submitted: ☐ Yes ☐ No Date ☐
Limestone			60	71	14. Well head completion: ☒ Pitless adapter 12 Inches above grade
Shale and limestone			71	95	15. Well grouted? yes 1-2 fine sand mix With: ☐ Neat cement ☐ Bentonite ☒ Concrete Depth: From 40" ft. to 14 ft.
Soft shale			95	142	16. Nearest source of possible contamination: ft. ☐ Direction ☐ Type None Well disinfected upon completion? ☒ Yes ☐ No
(Use a second sheet if needed)					17. Pump: ☐ Not installed Manufacturer's name Pioneer Model number A35 HP 1 1/2 Volts 230 Length of drop pipe 120 ft. capacity 20 g.p.m. Type: ☒ Submersible ☐ Turbine ☐ Jet ☐ Reciprocating ☐ Centrifugal ☐ Other
18. Elevation: Topography: ☐ Hill ☐ Slope ☐ Upland ☐ Valley	19. Remarks: Flat ground Septic system not installed at this time No apparent source for contamination.		20. Water well contractor's certification: This well was drilled under my jurisdiction and this report is true to the best of my knowledge and belief. Harp Well & Pump 236 Business name License No. Address Wichita, Kansas 67209 Signed M. Arnold date 3-3-79 Authorized representative		

Forward the white, blue and pink copies to the Department of Health and Environment

Form WWC-5