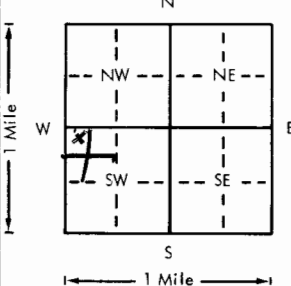
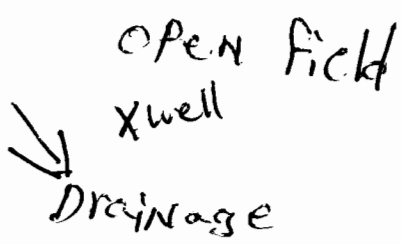


USE TYPEWRITER OR BALL
POINT PEN-PRESS FIRMLY,
PRINT CLEARLY.

WATER WELL RECORD
KSA 82a-1201-1215

Kansas Department of Health and
Environment-Division of Environment
(Water well Contractors)
Topeka, Kansas 66620

1. Location of well:		County Butler	Fraction NW 1/4 NW 1/4 SW 1/4	Section number 8	Township number T 28 S R 4 E	Range number 4
2. Distance and direction from nearest town or city: 2 mi. 3/4 S. of Augusta Ks.		3. Owner of well: RON Nibbelink R.R. or street: 1668 Battin City, state, zip code: Wichita Ks. 67218				
4. Locate with "X" in section below:		Sketch map:				
						
5. Type and color of material		From	To	6. Bore hole dia. 7 in. Completion date 7-10-79 Well depth 76 ft.		
Clay Red		0	5	7. ☒ Cable tool ☐ Rotary ☐ Driven ☐ Dug ☐ Hollow rod ☐ Jetted ☐ Bored ☐ Reverse rotary		
clay yellow		5	15	8. Use: ☒ Domestic ☐ Public supply ☐ Industry ☐ Irrigation ☐ Air conditioning ☐ Stock ☐ Lawn ☐ Oil field water ☐ Other		
Limestone yellow		15	17	9. Casing: Material PVC Height: Above or below Threated ☐ Welded ☐ Surface 14 in. RMP ☐ PVC ☒ Weight ☐ lbs./ft. Dia. 5 in. to 76 ft. depth Wall Thickness: inches or Dia. ☐ in. to ☐ ft. depth gage No. 300		
Clay with gravel yellow Red		17	21	10. Screen: Manufacturer's name Jet stream Type PVC Dia. 5 in. Slot/gauze 1/16 Length 20 ft. Set between 56 ft. and 76 ft. ft. and ☐ ft. Gravel pack? ☒ Size range of material 1/8 - 3/4		
Limestone yellow		21	29	11. Static water level: ☐ mo./day/yr. 19 ft. below land surface Date 7-10-79		
Shale gray green		29	39	12. Pumping level below land surfaces: NA ft. after ☐ hrs. pumping ☐ g.p.m. ft. after ☐ hrs. pumping ☐ g.p.m. Estimated maximum yield ☐ g.p.m.		
Shale Light gray		39	55	13. Water sample submitted: ☐ mo./day/yr. ☐ Yes ☒ No Date ☐		
Shale Gray		55	76	14. Well head completion: ☒ Pitless adapter 14 inches above grade		
(Water at 51')				15. Well grouted? yes With: ☐ Neat cement ☐ Bentonite ☒ Concrete Depth: From 13 ft. to 3 ft.		
				16. Nearest source of possible contamination: NA ft. ☐ Direction ☐ Type ☐ Well disinfected upon completion? ☒ Yes ☐ No		
				17. Pump: ☒ Not installed Manufacturer's name ☐ Model number ☐ HP ☐ Volts ☐ Length of drop pipe ☐ ft. capacity ☐ g.p.m. Type: ☐ Submersible ☐ Turbine ☐ Jet ☐ Reciprocating ☐ Centrifugal ☐ Other		
18. Elevation:		19. Remarks: owner will install concrete skb		20. Water well contractor's certification: This well was drilled under my jurisdiction and this report is true to the best of my knowledge and belief. Braddy water wells 363 Business name ☐ License No. ☐ Address Rt 2 Douglas Ks Signed Richard Braddy Date 7-10-79 Authorized representative		

Forward the white, blue and pink copies to the Department of Health and Environment

Form WWC-5