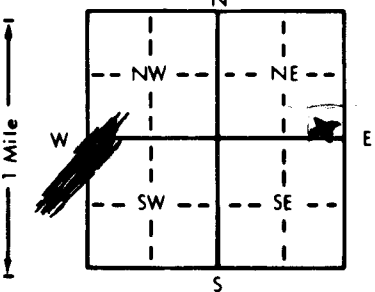


1 LOCATION OF WATER WELL:		Fraction	Section Number	Township Number	Range Number
County: <u>Butler</u>		<u>SE</u> $\frac{1}{4}$ <u>SE</u> $\frac{1}{4}$ <u>NE</u> $\frac{1}{4}$	<u>11</u>	<u>T 28 S</u>	<u>R 4</u> EW
Distance and direction from nearest town or city street address of well if located within city? <u>From the NE corner of Sec. 11</u>					
2536' S. and 340' W.					
2 WATER WELL OWNER: <u>Herman Hoge</u>					
RR#, St. Address, Box #: <u>Rt. #5</u>					
City, State, ZIP Code: <u>Augusta, Ks. 67010</u>					
Board of Agriculture, Division of Water Resources					
Application Number:					
3 LOCATE WELL'S LOCATION WITH AN "X" IN SECTION BOX:		4 DEPTH OF COMPLETED WELL: <u>134</u> ft. ELEVATION:			
		Depth(s) Groundwater Encountered <u>1.60</u> ft. 2. ft. 3. ft.			
		WELL'S STATIC WATER LEVEL <u>43.8</u> ft. below land surface measured on mo/day/yr <u>3/16/74</u>			
		Pump test data: Well water was ft. after hours pumping gpm			
		Est. Yield <u>5</u> gpm: Well water was ft. after hours pumping gpm			
		Bore Hole Diameter <u>10</u> in. to <u>1.34</u> ft. and in. to ft.			
		WELL WATER TO BE USED AS:			
		1 Domestic 3 Feedlot 6 Oil field water supply 8 Air conditioning 11 Injection well			
		2 Irrigation 4 Industrial 7 Lawn and garden only 10 Dewatering 12 Other (Specify below)			
		Was a chemical/bacteriological sample submitted to Department? Yes <u>No</u> If yes, mo/day/yr sample was submitted			
		Water Well Disinfected? <u>Yes</u> No			
5 TYPE OF BLANK CASING USED:					
1 Steel 3 RMP (SR) 5 Wrought iron 8 Concrete tile CASING JOINTS: <u>Glued</u> Clamped					
<u>2 PVC</u> 4 ABS 6 Asbestos-Cement 9 Other (specify below) Welded					
7 Fiberglass Threaded					
Blank casing diameter <u>5</u> in. to <u>44</u> ft., Dia in. to ft., Dia in. to ft.					
Casing height above land surface <u>1.8</u> in., weight <u>1.60</u> lbs./ft. Wall thickness or gauge No.					
TYPE OF SCREEN OR PERFORATION MATERIAL:					
1 Steel 3 Stainless steel 5 Fiberglass 8 RMP (SR) 10 Asbestos-cement					
2 Brass 4 Galvanized steel 6 Concrete tile 9 ABS 11 Other (specify)					
12 None used (open hole)					
SCREEN OR PERFORATION OPENINGS ARE:					
1 Continuous slot 3 Mill slot 5 Gauzed wrapped <u>8 Saw cut</u> 11 None (open hole)					
2 Louvered shutter 4 Key punched 6 Wire wrapped 9 Drilled holes					
7 Torch cut 10 Other (specify)					
SCREEN-PERFORATED INTERVALS: From <u>134</u> ft. to <u>44</u> ft., From ft. to ft.					
From ft. to ft., From ft. to ft.					
GRAVEL PACK INTERVALS: From <u>134</u> ft. to <u>40</u> ft., From ft. to ft.					
From ft. to ft., From ft. to ft.					
6 GROUT MATERIAL: 1 Neat cement <u>2 Cement grout</u> <u>3 Bentonite</u> 4 Other					
Grout Intervals: From <u>23</u> ft. to <u>15</u> ft., From <u>15</u> ft. to <u>3</u> ft., From ft. to ft.					
What is the nearest source of possible contamination:					
1 Septic tank 4 Lateral lines 7 Pit privy 10 Livestock pens 14 Abandoned water well					
2 Sewer lines 5 Cess pool <u>8 Sewage lagoon</u> 11 Fuel storage 15 Oil well/Gas well					
3 Watertight sewer lines 6 Seepage pit 9 Feedyard 12 Fertilizer storage 16 Other (specify below)					
13 Insecticide storage					
Direction from well? <u>NE</u> How many feet? <u>175</u>					
FROM	TO	LITHOLOGIC LOG	FROM	TO	PLUGGING INTERVALS
0.0	4.0	Top Soil			
4.0	15.0	Yellow gray limestone			
15.0	35.0	Yellow gray shale			
35.0	44.8	Purple shale			
44.8	57.0	Reddish purple shale			
57.0	90.0	Yellow gray shale with inter-bedded layers of clay			
90.0	97.0	Gray limestone			
97.0	122.5	Lighter gray fissal shale			
122.5	125.0	Blue gray clay			
125.0	134.0	Light gray fissal shale			
7 CONTRACTOR'S OR LANDOWNER'S CERTIFICATION: This water well was <u>(1) constructed</u> , (2) reconstructed, or (3) plugged under my jurisdiction and was completed on (mo/day/year) <u>3/16/94</u> and this record is true to the best of my knowledge and belief. Kansas Water Well Contractor's License No. <u>279</u> This Water Well Record was completed on (mo/day/yr) <u>3/28/94</u> under the business name of <u>Fudge Drilling</u> by (signature) <u>Melvin R. Fudge</u>					