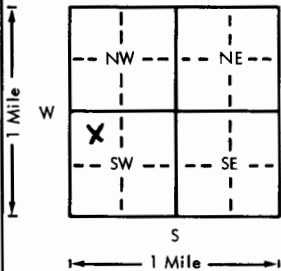
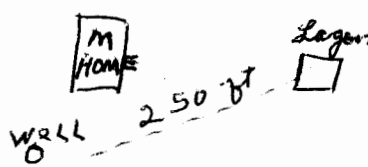


USE TYPEWRITER OR BALL
POINT PEN-PRESS FIRMLY,
PRINT CLEARLY.

WATER WELL RECORD
KSA 82a-1201-1215

Kansas Department of Health and
Environment-Division of Environment
(Water well Contractors)
Topeka, Kansas 66620

1. Location of well:	County <u>Butler</u>	Fraction <u>C 1/4 NW 1/4 SW 1/4</u>	Section number <u>12</u>	Township number <u>T 28</u>	Range number <u>S R 4</u>	<u>EW</u>
2. Distance and direction from nearest town or city: <u>25-2 E, 1/2 S</u>		3. Owner of well: <u>Dennis Halliart</u>				
Street address of well location if in city: <u>Augusta</u>		R.R. or street: <u>R#3</u>				
		City, state, zip code: <u>Augusta Kansas 67010</u>				
4. Locate with "X" in section below:		Sketch map:		6. Bore hole dia. <u>10</u> in. Completion date <u>3-18-76</u>		
				Well depth <u>60</u> ft.		
5. Type and color of material		From	To	7. ☒ Cable tool ☐ Rotary ☐ Driven ☐ Dug		
<u>Red Clay</u>		<u>0</u>	<u>4</u>	☐ Hollow rod ☐ Jetted ☐ Bored ☐ Reverse rotary		
<u>Red clay & gravel</u>		<u>4</u>	<u>15</u>	8. Use: ☒ Domestic ☐ Public supply ☐ Industry		
<u>grey lime</u>		<u>15</u>	<u>25</u>	☐ Irrigation ☐ Air conditioning ☐ Stock		
<u>yellow lime</u>		<u>25</u>	<u>50</u>	☐ Lawn ☐ Oil field water ☐ Other		
<u>water</u>		<u>50</u>		9. Casing: Material <u>plastic</u> Height: <u>above</u> or below		
<u>yellow clay</u>		<u>50</u>	<u>60</u>	Threaded ☐ Welded ☒ Surface <u>12</u> in.		
				RMP ☒ PVC ☐ Weight <u>12</u> lbs./ft.		
				Dia. <u>6</u> in. to <u>60</u> ft. depth Wall Thickness: inches or		
				Dia. <u>6</u> in. to <u>60</u> ft. depth gage No. <u>175</u>		
				10. Screen: Manufacturer's name <u>OKLahoma City</u>		
				Type <u>RMP</u> Dia. <u>6</u>		
				Slot/gauge <u>1/16</u> Length <u>20</u>		
				Set between <u>40</u> ft. and <u>60</u> ft.		
				Gravel pack? <u>no</u> Size range of material		
				11. Static water level: <u>32</u> ft. below land surface Date <u>3-18-76</u>		
				12. Pumping level below land surfaces:		
				ft. after hrs. pumping g.p.m.		
				ft. after hrs. pumping g.p.m.		
				Estimated maximum yield <u>15</u> g.p.m.		
				13. Water sample submitted: <u>Yes</u> ☒ No ☐ Date		
				14. Well head completion: <u>12</u> inches above grade		
				15. Well grouted? ☒ With: ☒ Neat cement ☐ Bentonite ☐ Concrete		
				Depth: From <u>18</u> ft. to <u>5</u> ft.		
				16. Nearest source of possible contamination: <u>250</u> ft. Direction <u>N.E.</u> Type <u>Lagoon</u>		
				Well disinfected upon completion? ☒ Yes ☐ No		
				17. Pump: ☒ Not installed		
				Manufacturer's name		
				Model number HP Volts		
				Length of drop pipe ft. capacity g.p.m.		
				Type:		
				☐ Submersible ☐ Turbine		
				☐ Jet ☐ Reciprocating		
				☐ Centrifugal ☐ Other		
18. Elevation:		19. Remarks:		20. Water well contractor's certification:		
Topography:		<u>well will be in basement</u>		This well was drilled under my jurisdiction and this report		
☐ Hill		<u>Dennis M. Halliart</u>		is true to the best of my knowledge and belief.		
☐ Slope				<u>Mike Well Drilling</u> License No.		
☒ Upland				Business name <u>Route 3 Augusta</u>		
☐ Valley				Address <u>Route 3 Augusta</u>		
				Signed <u>Murray Mike</u> Date <u>3-18-76</u>		
				Authorized representative		