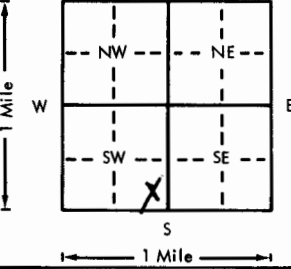
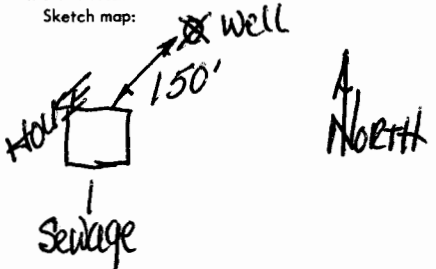


USE TYPEWRITER OR BALL
POINT PEN-PRESS FIRMLY,
PRINT CLEARLY.

WATER WELL RECORD
KSA 82a-1201-1215

Kansas Department of Health and
Environment-Division of Environment
(Water well Contractors)
Topeka, Kansas 66620

1. Location of well:	County BUTLER	Fraction SE 1/4 SW 1/4	Section number 26	Township number T 28 S	Range number R 4 E
2. Distance and direction from nearest town or city: 4 N. 9 E. OF DOUGLASS		3. Owner of well: RICHARD HEWLETT R.R. or street: R 2 BOX 86 B City, state, zip code: DOUGLASS, KS.			
4. Locate with "X" in section below:		Sketch map:		6. Bore hole dia. 12 (in.) Completion date 6-30-75 Well depth 110 ft. 15	
				7. ☒ Cable tool ☐ Rotary ☐ Driven ☐ Dug ☐ Hollow rod ☐ Jetted ☐ Bored ☐ Reverse rotary	
5. Type and color of material		From	To	8. Use: ☒ Domestic ☐ Public supply ☐ Industry ☐ Irrigation ☐ Air conditioning ☐ Stock ☐ Lawn ☐ Oil field water ☐ Other	
Topsoil		0	5	9. Casing: Material HTS Height: Above or below Threaded ☒ Welded ☐ Surface 12 in. RMP ☒ PVC ☐ Weight 1.55 lbs./ft.	
loose rock and soapstone		5	9	Dia. 6 in. to 30 ft. depth Wall Thickness: inches or Dia. 6 in. to 30 ft. depth gage No. 0.300 0.175	
lime gray H ₂ O 30'		9	35	10. Screen: Manufacturer's name Sunflower Plaster Pipe Inc. Type HTS Dia. 6 Slot/gauze NO Length NO SCREEN Set between NO ft. and NO ft. OPEN Hole ft. Gravel pack? NO Size range of material	
shale lime		35	72	11. Static water level: 25 ft. below land surface Date 6/30/75 no./day/yr.	
shale hard		72	74	12. Pumping level below land surfaces: ____ ft. after ____ hrs. pumping ____ g.p.m. ____ ft. after ____ hrs. pumping ____ g.p.m. Estimated maximum yield ____ g.p.m.	
shale lime		74	80	13. Water sample submitted: ____ mo./day/yr. ____ Yes ☒ No Date	
lime light gray sandy		80	90	14. Well head completion: ____ Pitless adapter ____ inches above grade	
shale lime		90	96	15. Well grouted? YES With: ☒ Neat cement ☐ Bentonite ☐ Concrete Depth: From 4 ft. to 18 ft.	
shale red		96	100	16. Nearest source of possible contamination: ft. 145 Direction SW Type sewer Well disinfected upon completion? ☒ Yes ☐ No	
lime gray H ₂ O 100'		100	110	17. Pump: ☒ Not installed Manufacturer's name ____ Model number ____ HP ____ Volts ____ Length of drop pipe ____ ft. capacity ____ g.p.m. Type: ☐ Submersible ☐ Turbine ☐ Jet ☐ Reciprocating ☐ Centrifugal ☐ Other	
(Use a second sheet if needed)					
18. Elevation:	19. Remarks:		20. Water well contractor's certification:		
Topography: ☐ Hill ☐ Slope ☒ Upland ☐ Valley	This well had very small yield of water (1 gal per min) so we rimmed the hole out to 15" to make more reserve.		This well was drilled under my jurisdiction and this report is true to the best of my knowledge and belief. Reisner Well Drilling Business name no circle Dr. White, KS License No. ____ Address ____ Signed Jerry Reisner Date 8/4/78 Authorized representative		