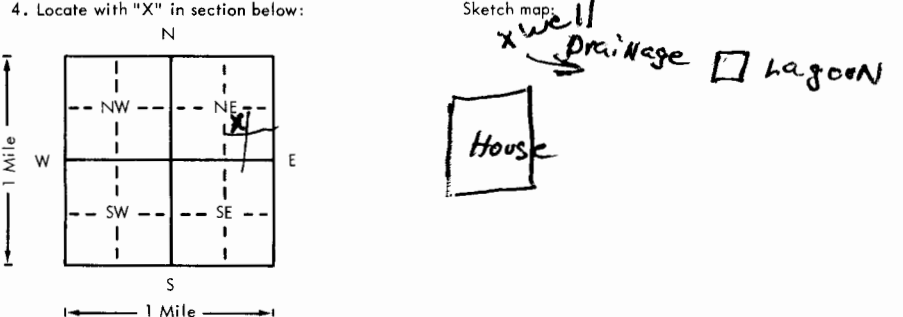


USE TYPEWRITER OR BALL
POINT PEN-PRESS FIRMLY,
PRINT CLEARLY.

WATER WELL RECORD
KSA 82a-1201-1215

Kansas Department of Health and
Environment-Division of Environment
(Water well Contractors)
Topeka, Kansas 66620

1. Location of well:	County Butler	Fraction NW 1/4 SE 1/4 NE 1/4	Section number 30	Township number T 28 S	Range number R 4 E
2. Distance and direction from nearest town or city: West 4 1/2 North of Douglass Ks			3. Owner of well: Lee Wilks R.R. or street: R#1 City, state, zip code: Rose Hill Ks		
4. Locate with "X" in section below: 			6. Bore hole dia. 8.5 in. Completion date 6-13-78 Well depth 89 ft.		
5. Type and color of material			7. ☒ Cable tool ☐ Rotary ☐ Driven ☐ Dug ☐ Hollow rod ☐ Jetted ☐ Bored ☐ Reverse rotary		
			8. Use: ☒ Domestic ☐ Public supply ☐ Industry ☐ Irrigation ☐ Air conditioning ☐ Stock ☐ Lawn ☐ Oil field water ☐ Other		
			9. Casing: Material Plst Height: Above or below Threaded ☐ Welded gluc Surface 24 in. RMP ☒ PVC ☐ Weight ☐ lbs./ft. Dia. 5 in. to 89 ft. depth Wall Thickness: inches or Dia. ☐ in. to ☐ ft. depth gage No. 200		
			10. Screen: Manufacturer's name SUNFLOWER PLTS PIPE INC Type RMP Dia. 5" Slot/gauze 1/16 Length 10' Set between 29 ft. and 89 ft. ft. and ☐ ft. Gravel pack? No Size range of material ☐		
			11. Static water level: ☐ mo./day/yr. 35 ft. below land surface Date 6-13-78		
(Use a second sheet if needed)			12. Pumping level below land surfaces: Na ☐ ft. after ☐ hrs. pumping ☐ g.p.m. ☐ ft. after ☐ hrs. pumping ☐ g.p.m. Estimated maximum yield ☐ g.p.m.		
			13. Water sample submitted: ☐ mo./day/yr. ☐ Yes ☒ No Date ☐		
			14. Well head completion: ☐ Pitless adapter 24 Inches above grade		
			15. Well grouted? yes With: ☐ Neat cement ☐ Bentonite ☒ Concrete Depth: From 11 ft. to 0 ft.		
			16. Nearest source of possible contamination: ft. 90' Direction East Type Lagoon Well disinfected upon completion? ☒ Yes ☐ No		
(Use a second sheet if needed)			17. Pump: ☒ Not installed Manufacturer's name ☐ Model number ☐ HP ☐ Volts ☐ Length of drop pipe ☐ ft. capacity ☐ g.p.m. Type: ☐ Submersible ☐ Turbine ☐ Jet ☐ Reciprocating ☐ Centrifugal ☐ Other		
			18. Elevation: Topography: ☒ Hill ☒ Slope ☐ Upland ☐ Valley		
			19. Remarks: owner will install concrete slab		
			20. Water well contractor's certification: This well was drilled under my jurisdiction and this report is true to the best of my knowledge and belief. Braddy water wells 363 Business name License No. Address R2 Box 217A Douglass Ks Signed Richard Braddy Date 6-13-78 Authorized representative		
			Sec 30 NW 1/4 SE 1/4		

Forward the white, blue and pink copies to the Department of Health and Environment

Form WWC-5